


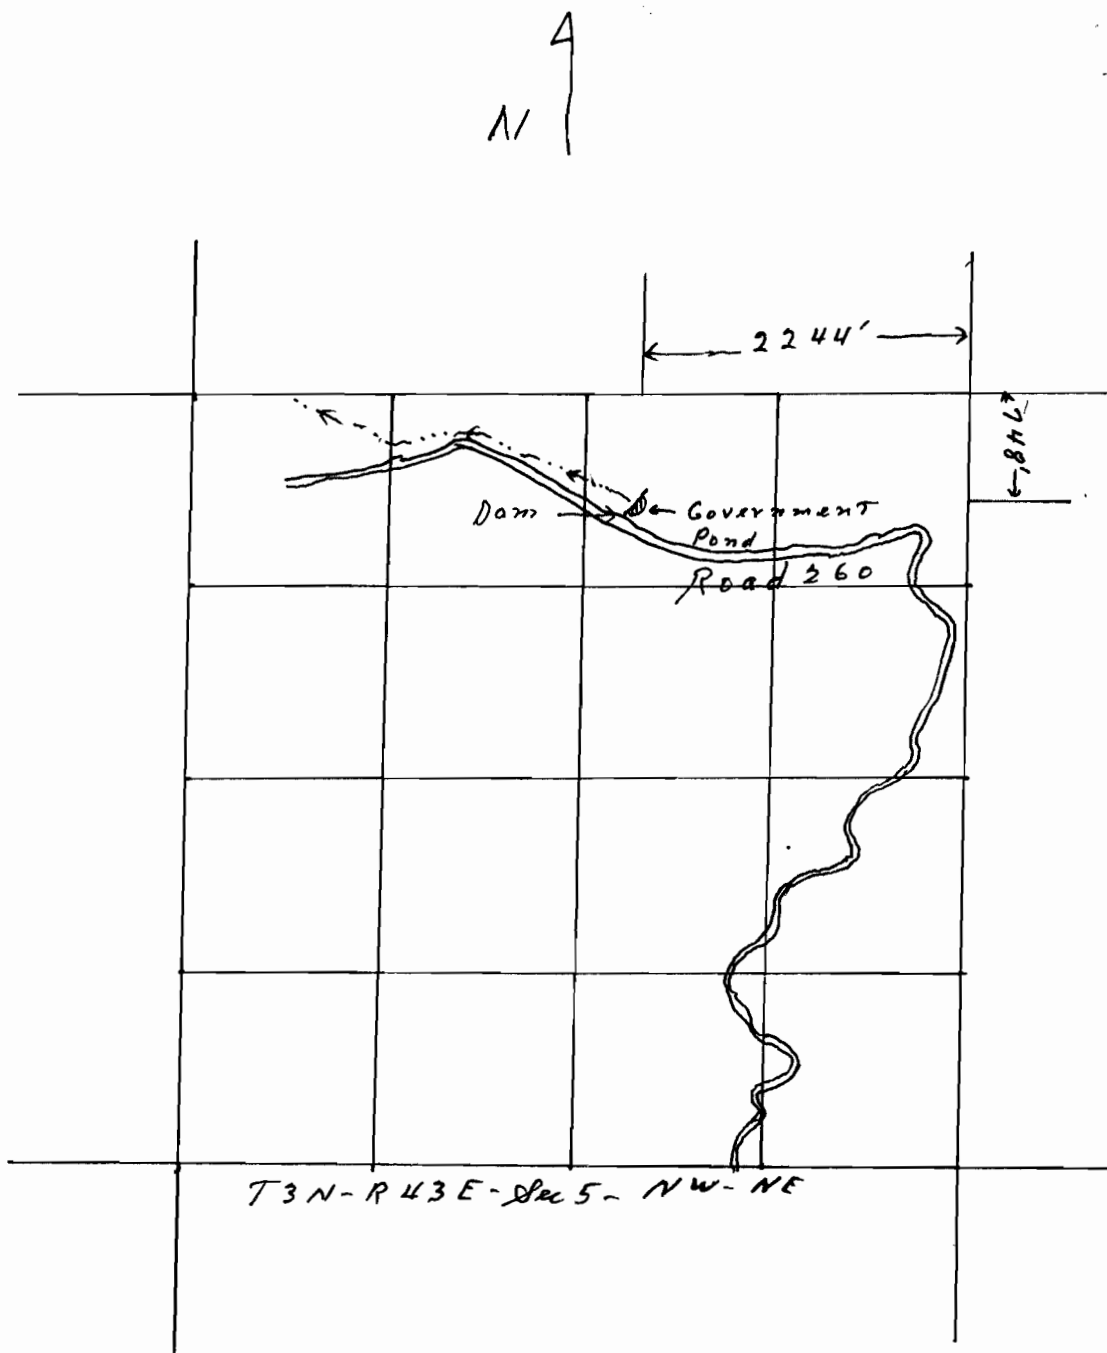

Application No. R-65774
 Permit No. R10754

4 inches = 1 mile

RECEIVED

APR 29 1982
 FOREST RESOURCES DEPT.
 SALEM, OREGON