


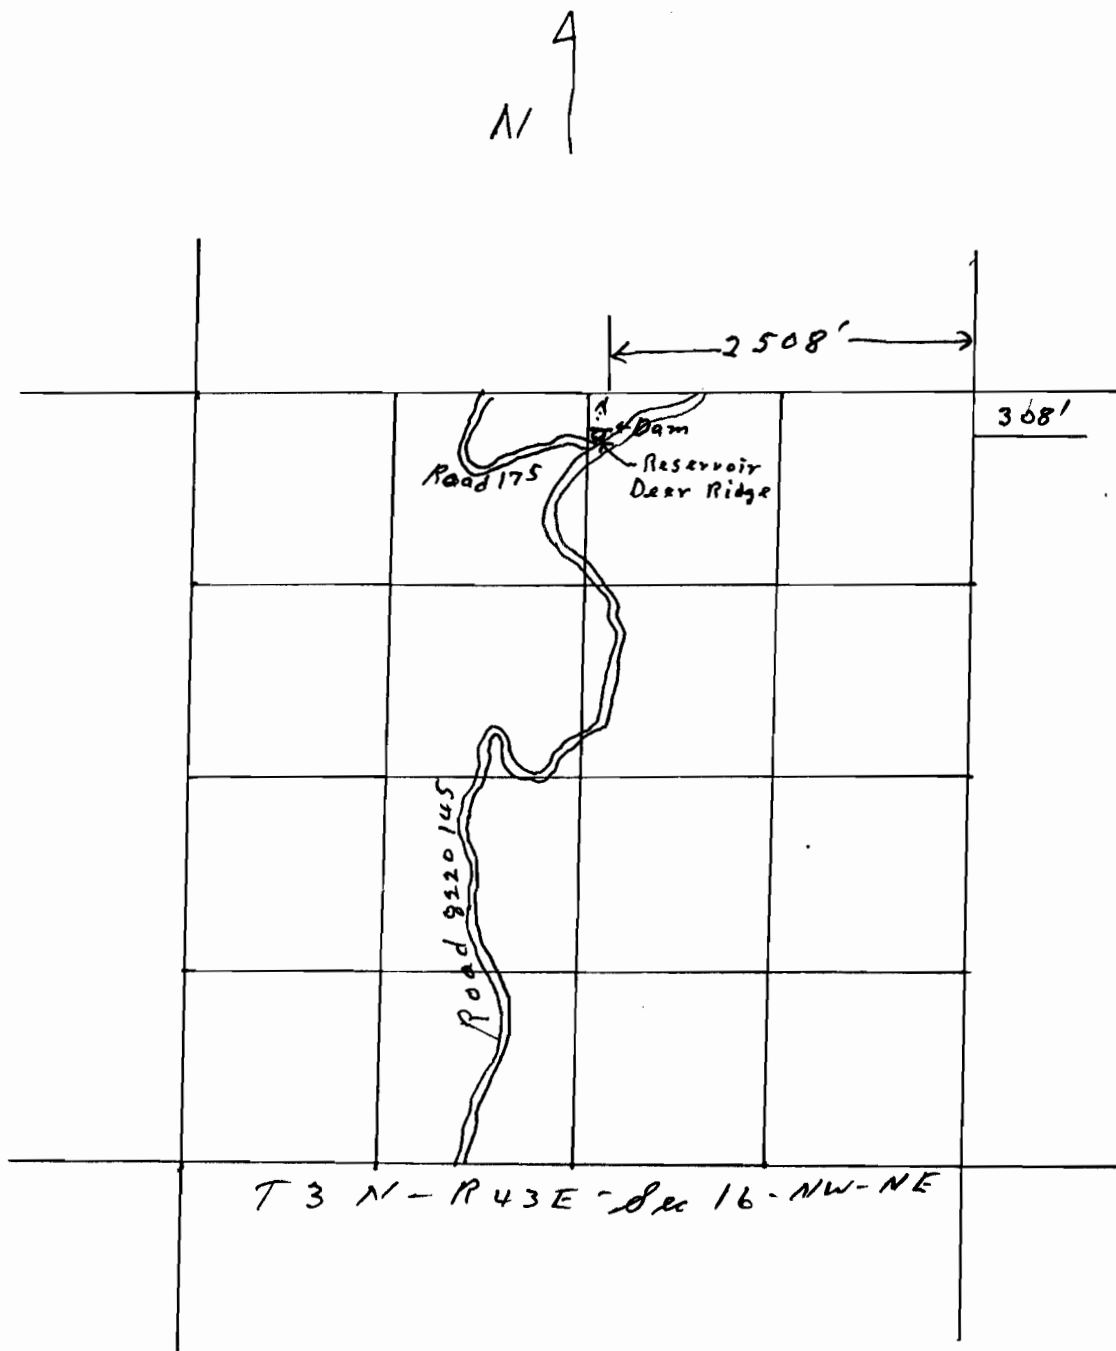

Application No. R-65776
 Permit No. R10756

4 inches = 1 mile

RECEIVED

APR 19 1992
 LAND RESOURCES DEPT
 SALEM, OREGON