


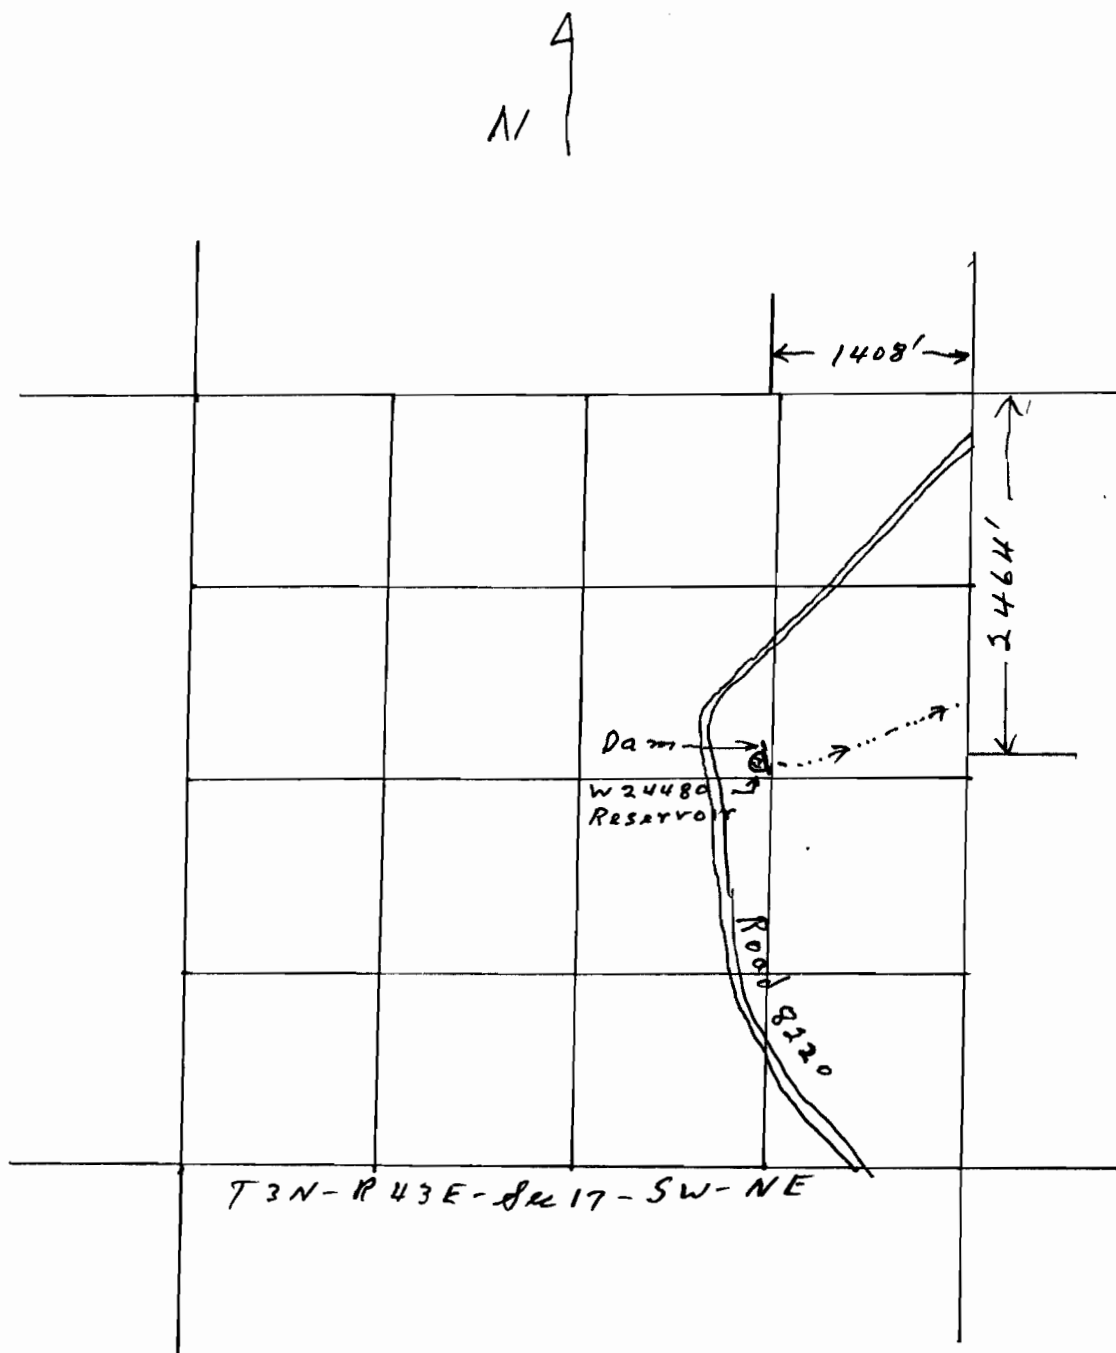

Application No. R-65777

Permit No. R10757

4 inches = 1 mile

RECEIVED

APR 19 1982

WATER RESOURCES DEPT
SALEM, OREGON