


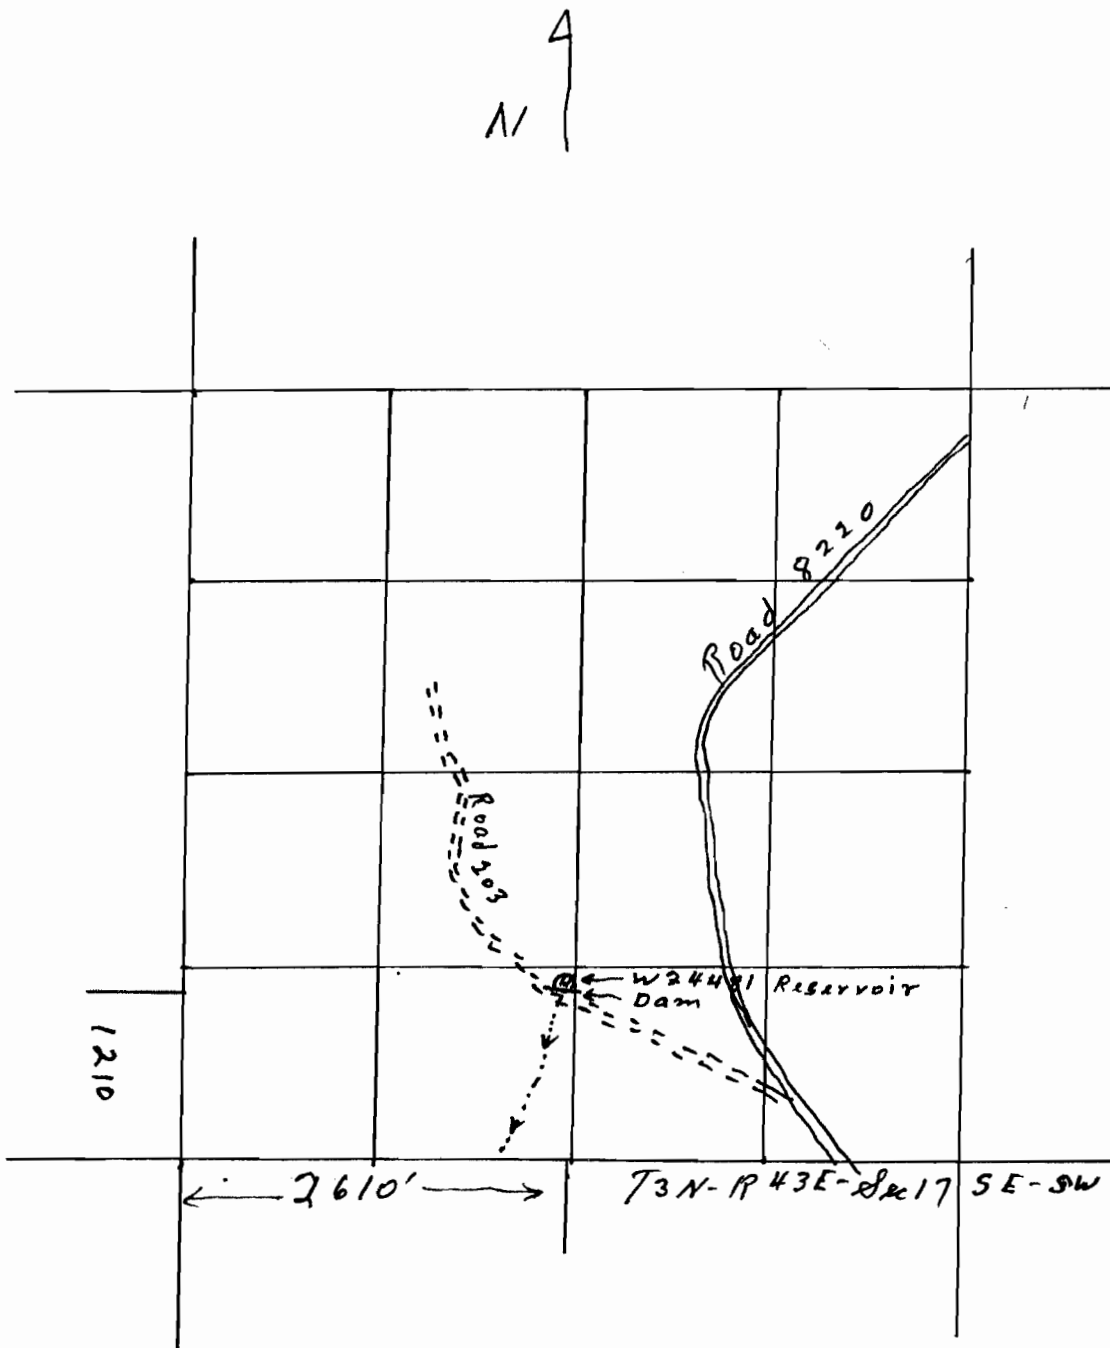

Application No. R-65778

Permit No. R10758

4 inches = 1 mile

RECEIVED
APR 30 1932
LAND RESOURCES DEPT
SALEM, OREGON