


N ↑

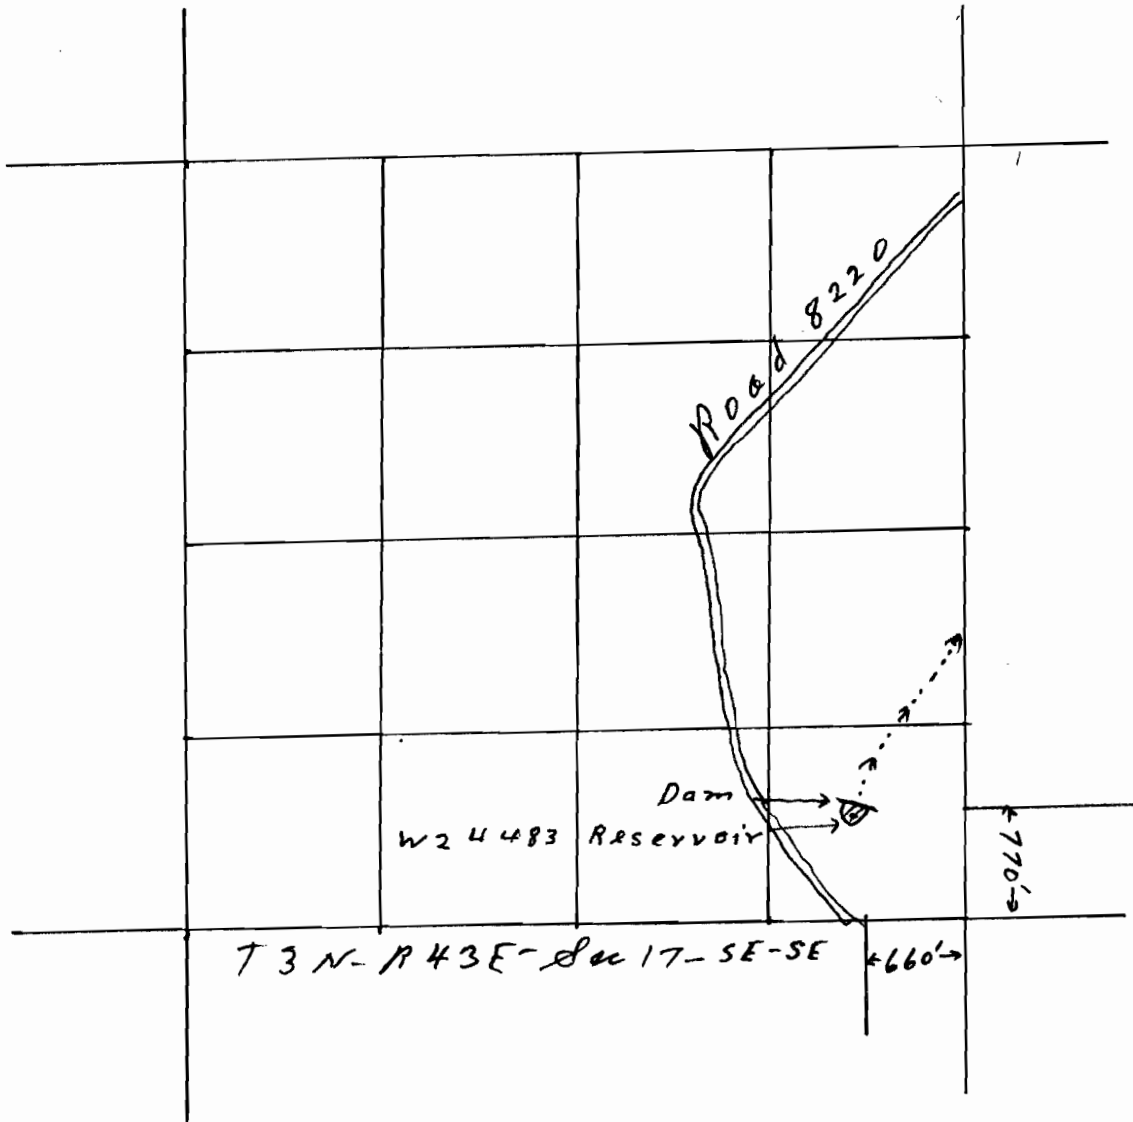

Application No. R-65779
Permit No. R10759

4 inches = 1 mile

RECEIVED
APR 19 1960
LAND OFFICES DEPT.
SALEM, OREGON