


N

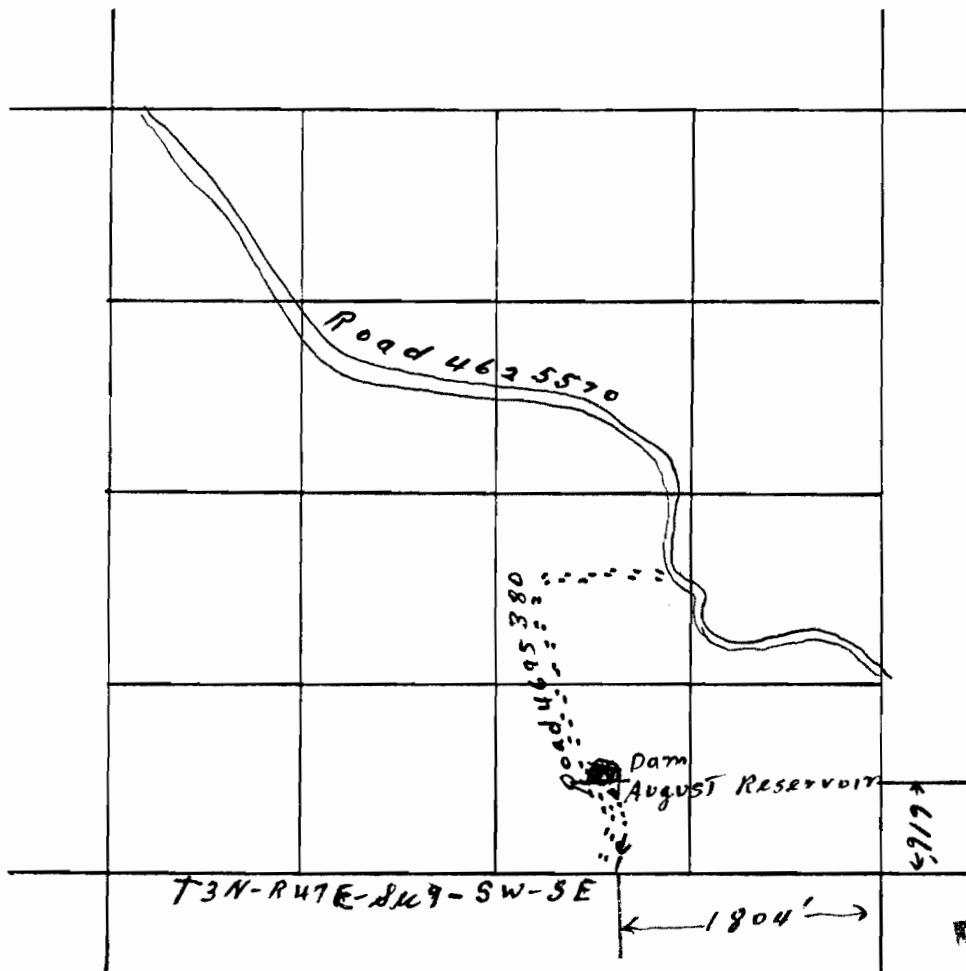

4 inches = 1 mile

Application No. R-65780
Permit No. R10760

RECEIVED
AUG 10 1983
LAND REVENUE DEPT.
SALEM, OREGON

RECEIVED
AUG 10 1983