


N

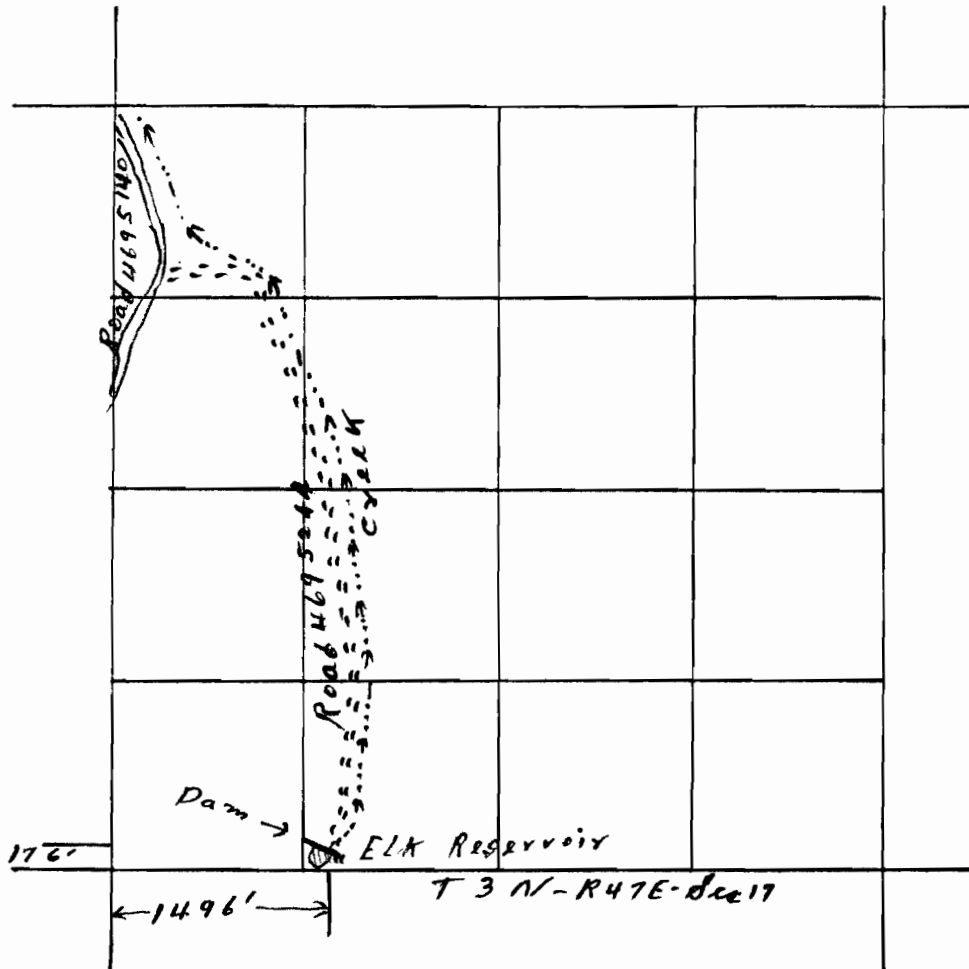

4 inches = 1 mile

Application No. R-65781
Permit No. R10761

RECEIVED

APR 19 1980

LAND SURVEY DEPT
SALEM, OREGON