


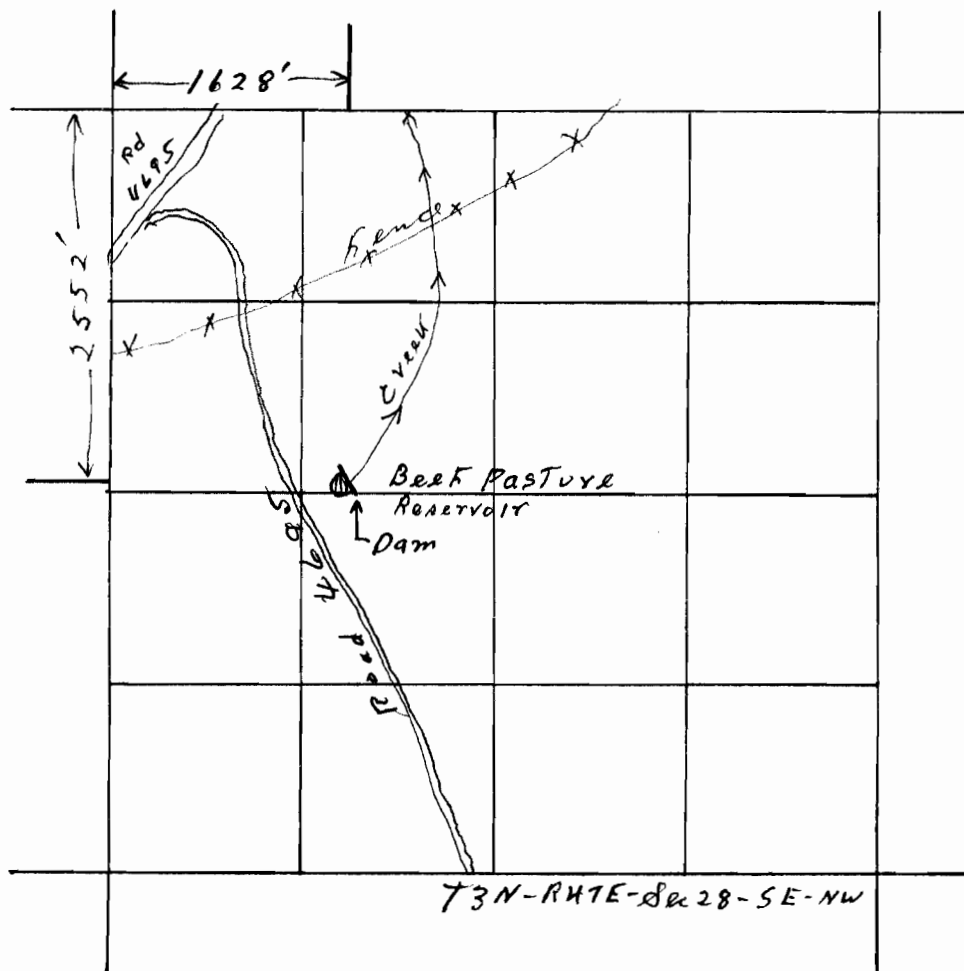

4 inches = 1 mile

Application No. R-65783

Permit No. R10763

RECEIVED
APR 19 1980
LAND REVENUE DEPT
SALEM, OREGON