


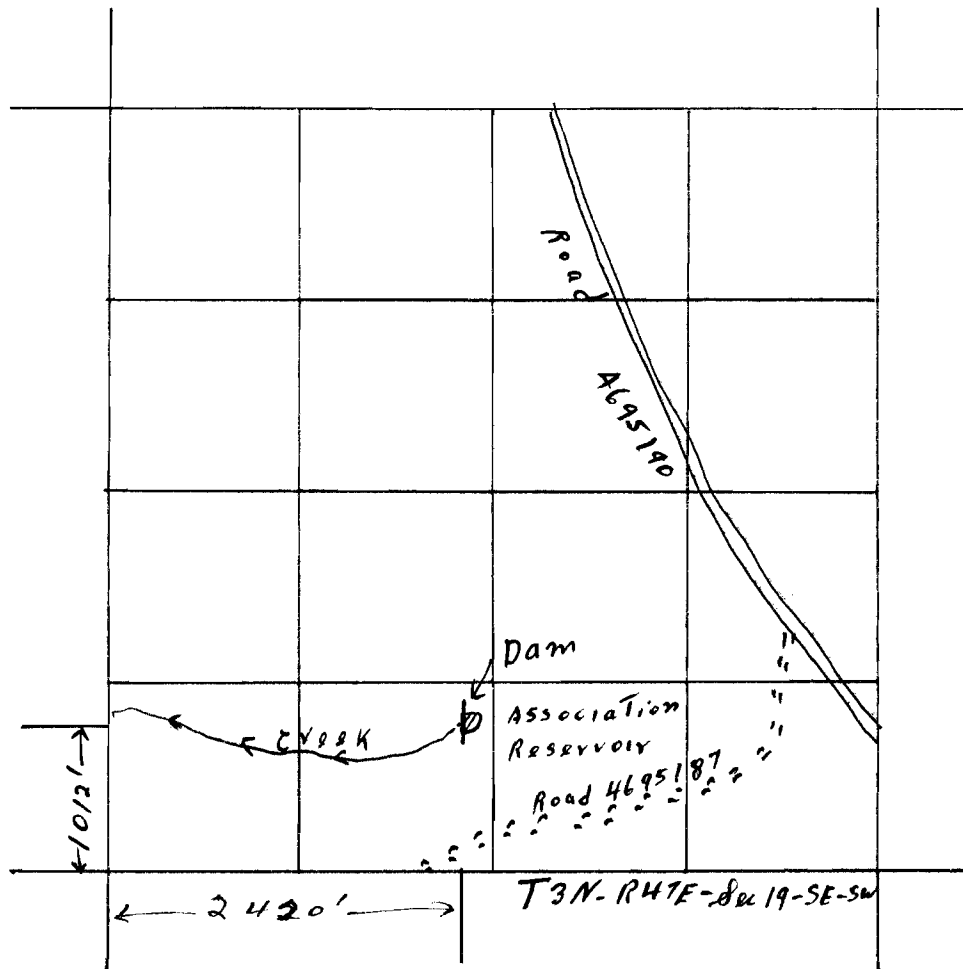

4 inches = 1 mile

Application No. R-65785

Permit No. R10765

RECEIVED
JAN 19 1988
LAND RESOURCES DEPT.
SALEM, OREGON