


N ↑

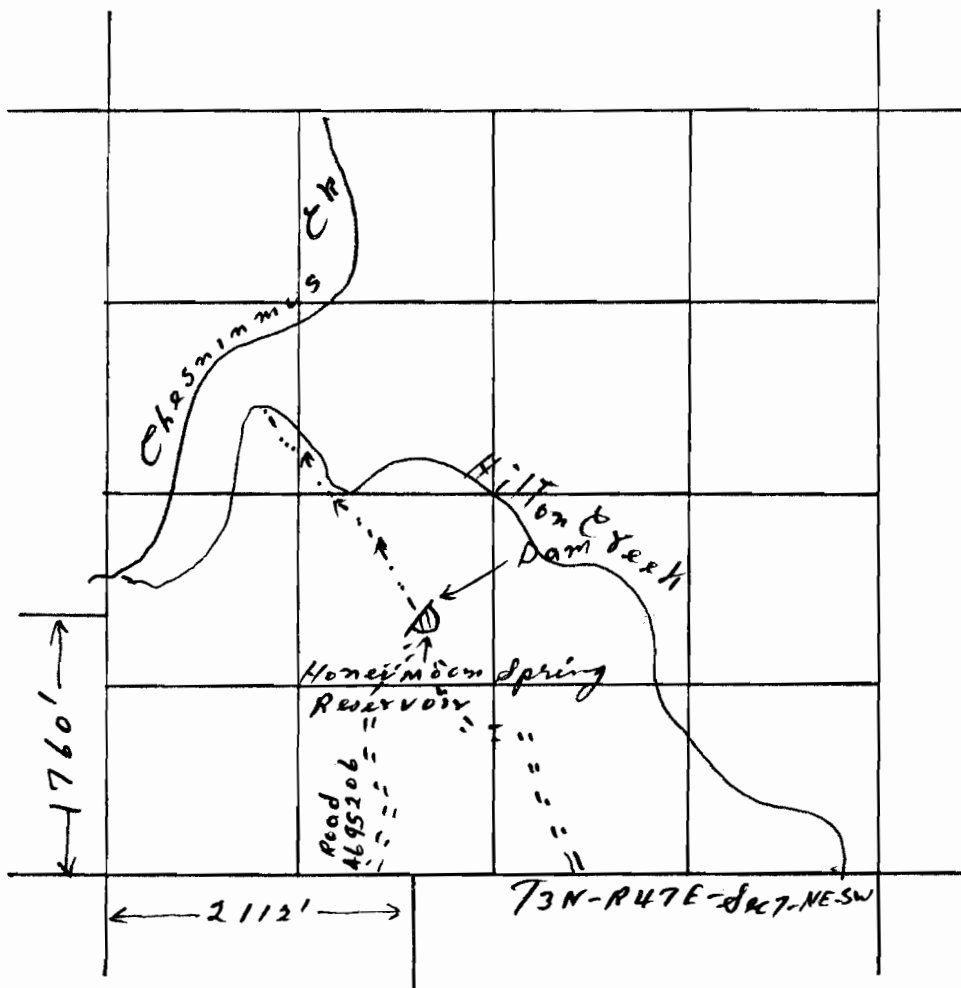

4 inches = 1 mile

Application No. R-65786
 Permit No. R10766

RECEIVED

APR 9 1962
 LAND REVENUE DEPT
 SALEM, OREGON