


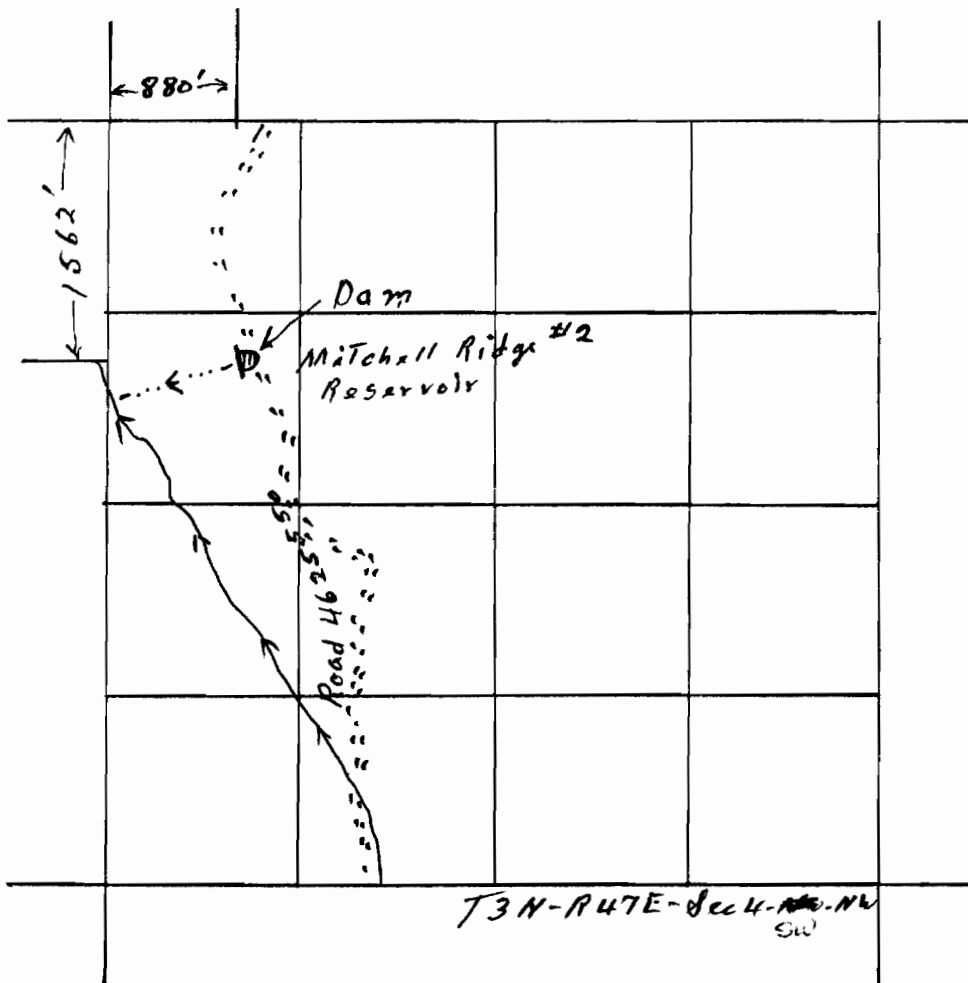

4 inches = 1 mile

Application No. R-65788
Permit No. R10768

RECEIVED
FEB 20 1968
FORESTRY DEPT
SALEM, OREGON