


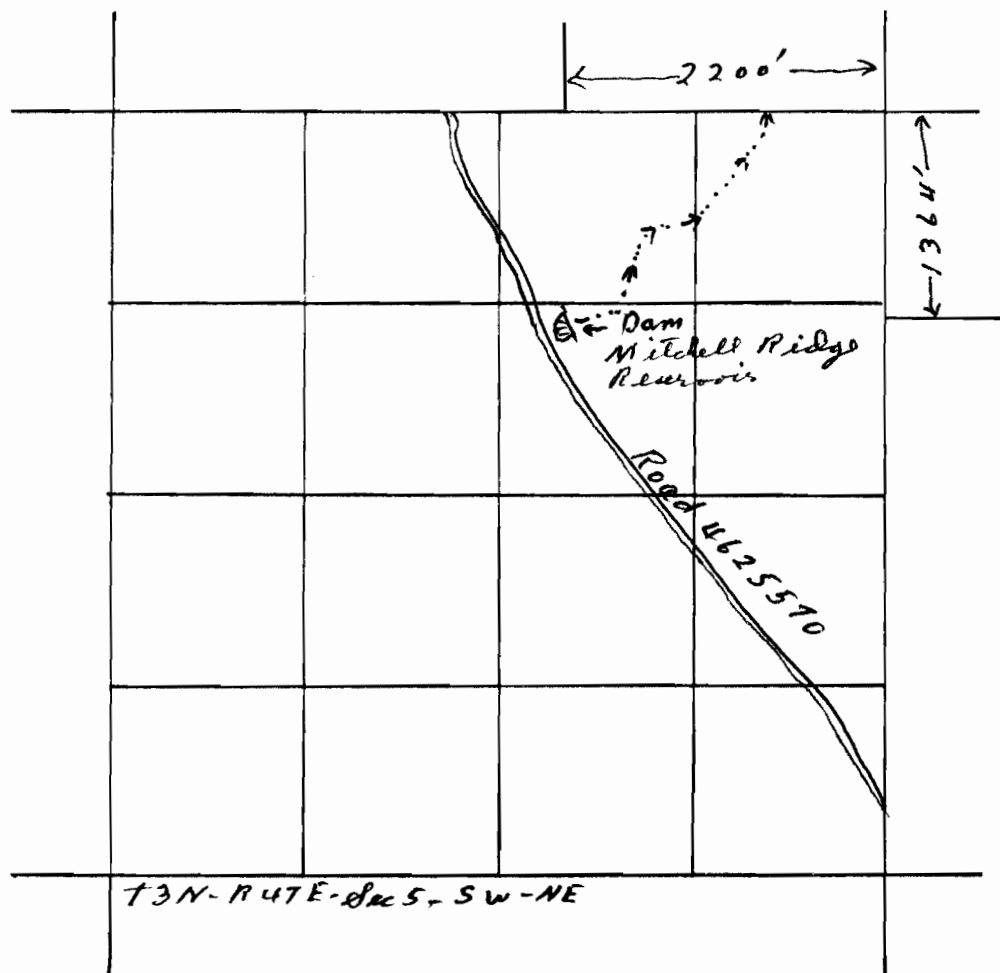

4 inches = 1 mile

Application No. R-65789
Permit No. R10769

RECEIVED
AUG 30 1960
LAND REVENUE DEPT
SALEM, OREGON