


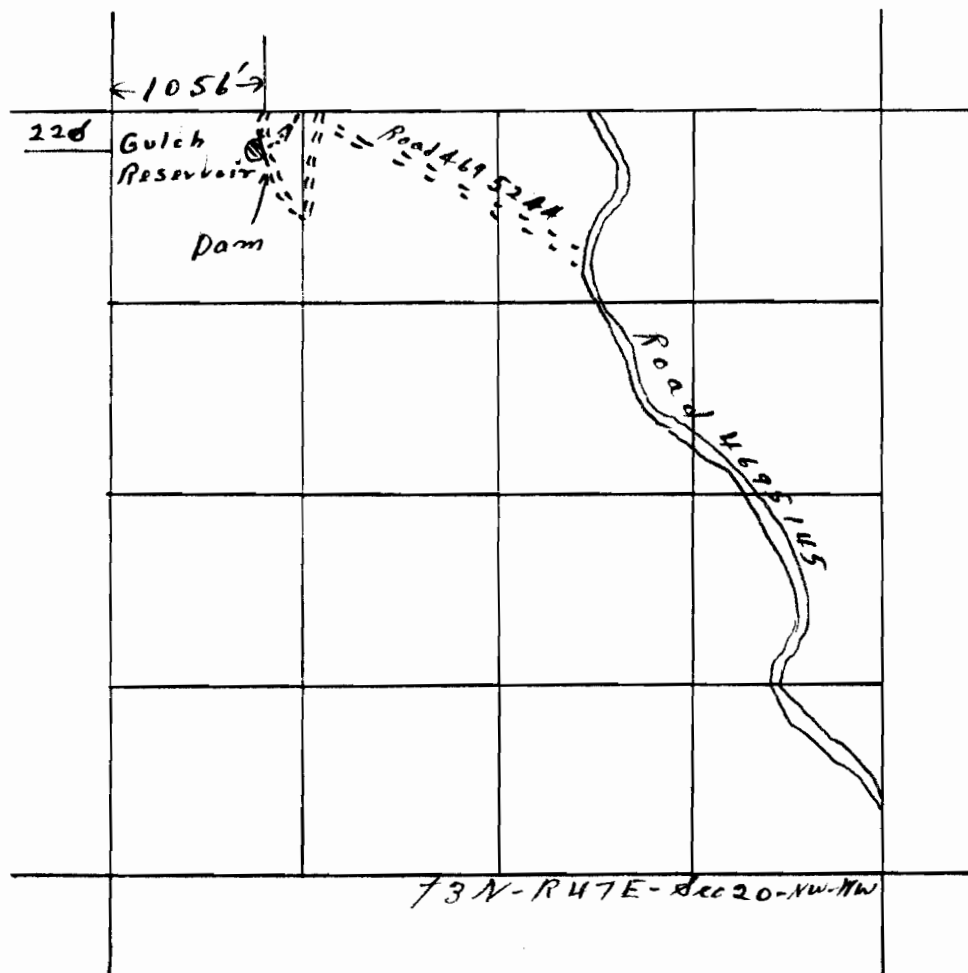

4 inches = 1 mile

Application No. R-65790
Permit No. R10770

RECEIVED

AUG 29 1982
LAND RESOURCES DEPT
SALEM, OREGON