
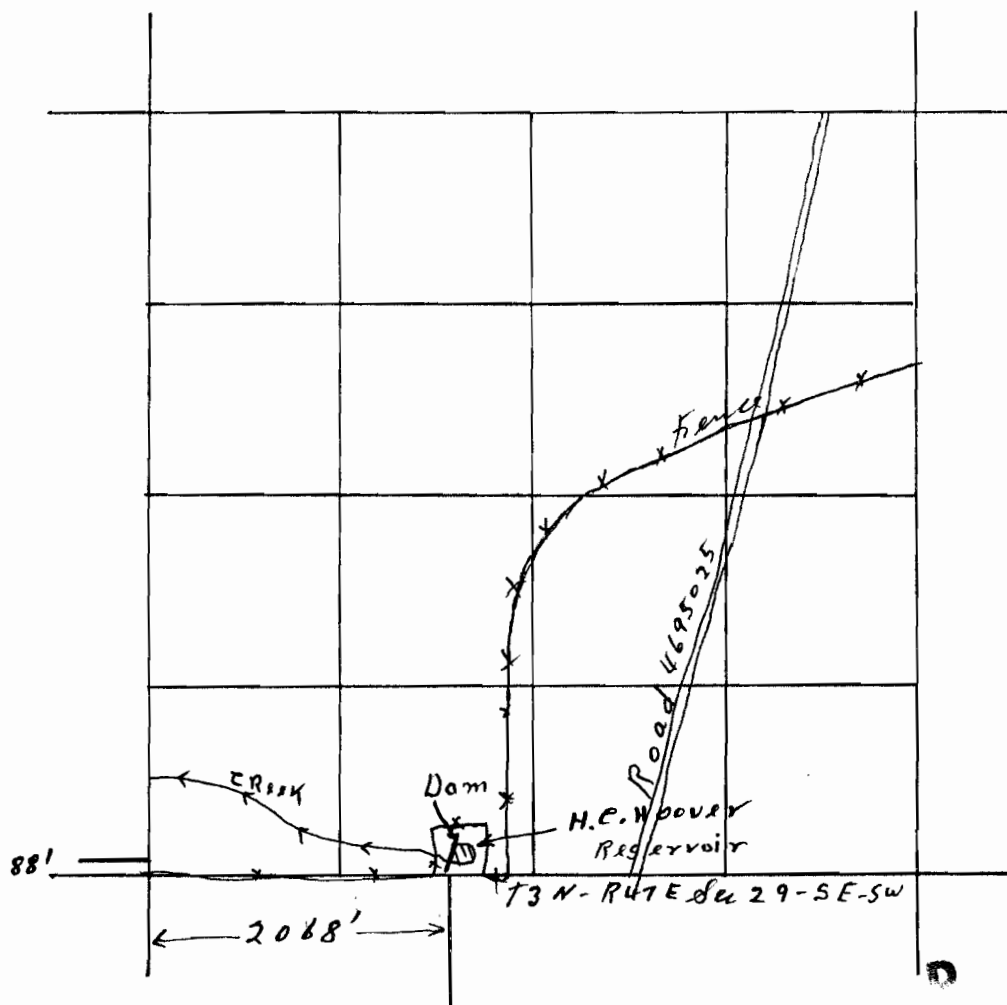


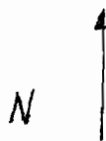

4 inches = 1 mile

Application No. R-65791
Permit No. R10771

RECEIVED
FEB 10 1972
LAND RESOURCES DEPT
SALEM, OREGON

RECEIVED
FEB 10 1972
LAND RESOURCES DEPT
SALEM, OREGON