


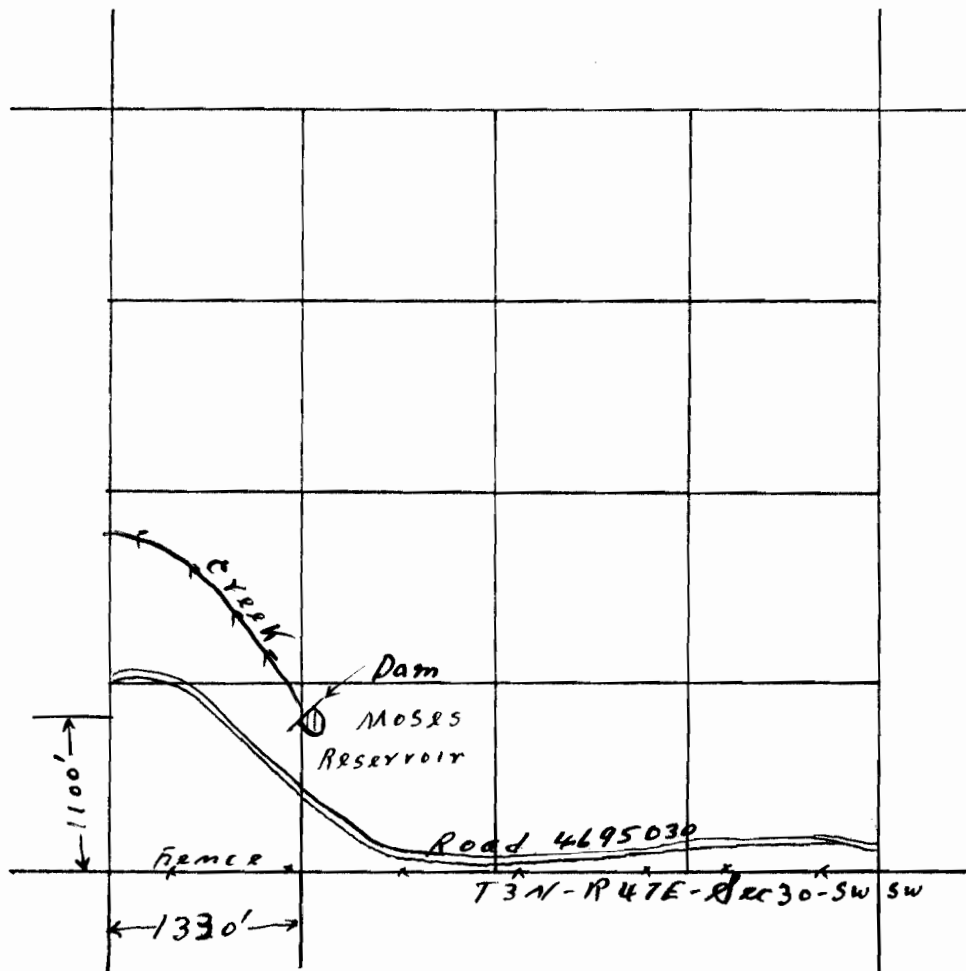

4 inches = 1 mile

Application No. R-65792  
Permit No. R10772

RECEIVED  
APR 30 1932  
LAND OFFICES DEPT  
SALEM, OREGON