


N ↑

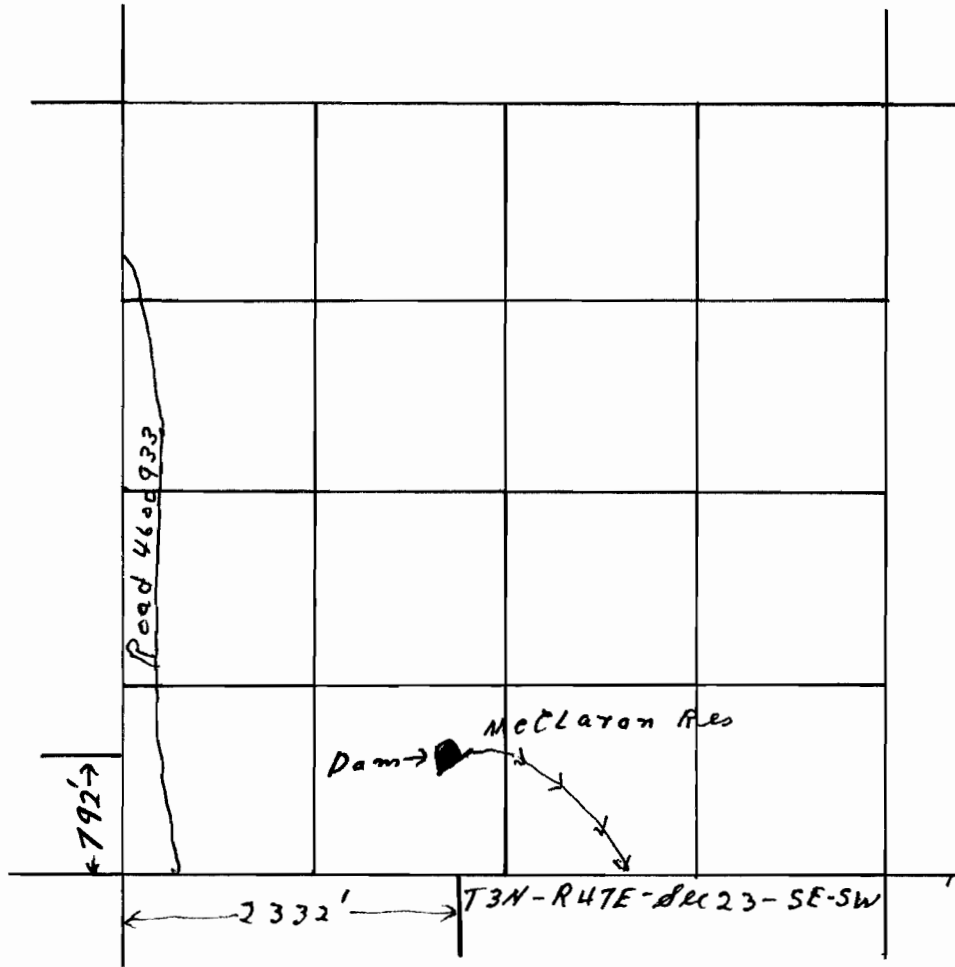

4 inches = 1 mile

Application No. R-65793
Permit No. R10773

RECEIVED

APR 18 1980
FIRE SERVICES DEPT
SALEM, OREGON