


N ↑

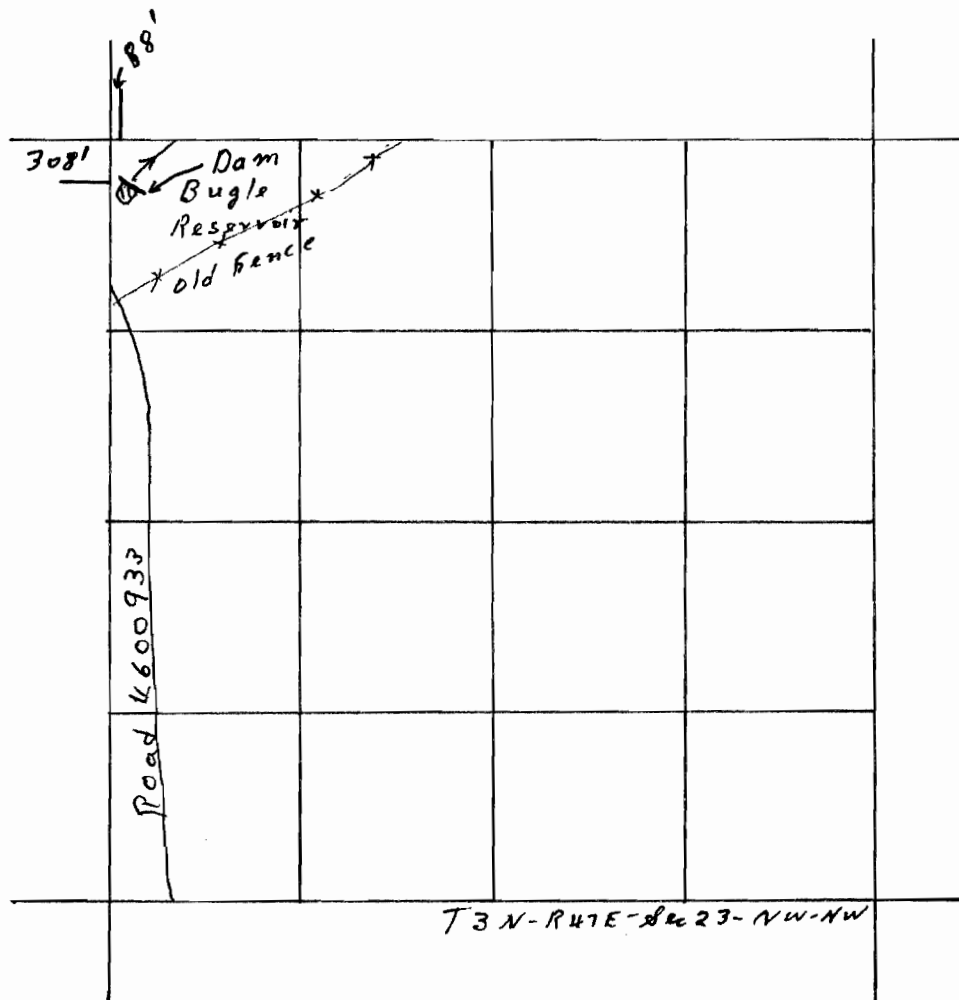

4 inches = 1 mile

Application No. R-65794
 Permit No. R10774

RECEIVED

NOV 30 1933

LAND RESOURCES DEPT
 SALEM, OREGON