


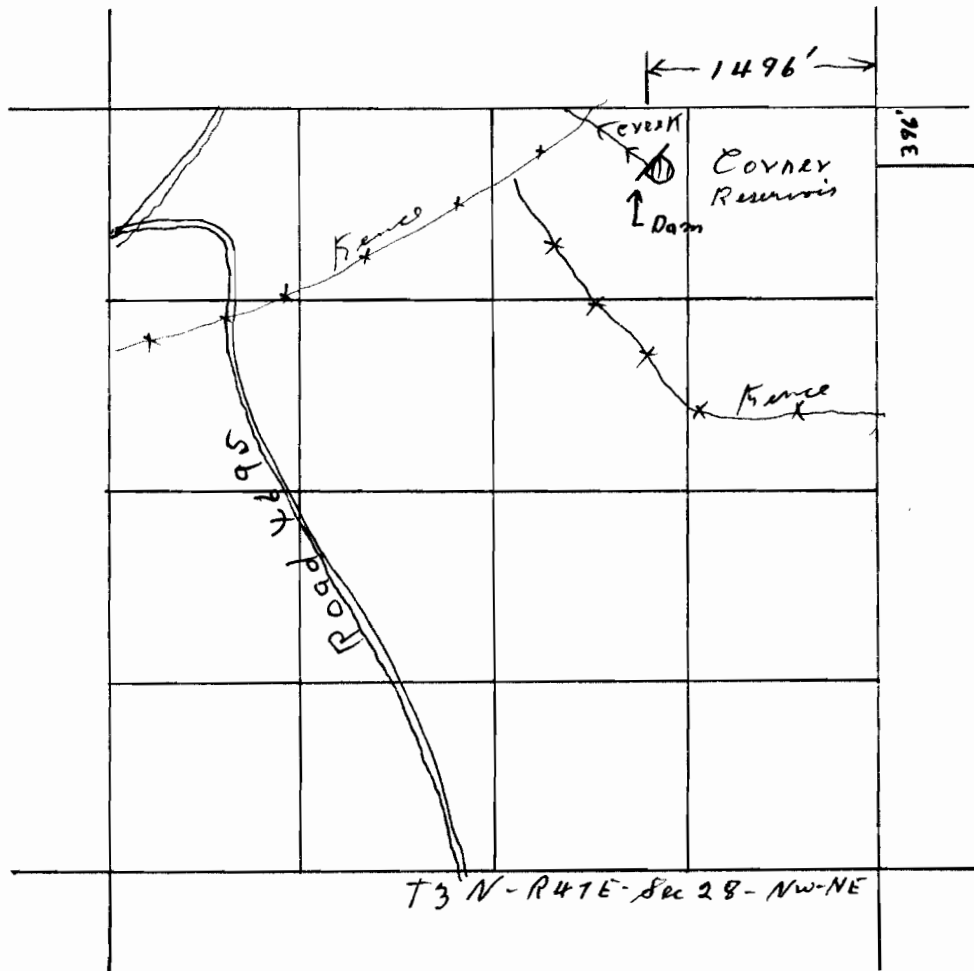

4 inches = 1 mile

Application No. R-65795
Permit No. R10775

RECEIVED
JUN 20 1983
FISH AND WILDLIFE DEPT
SALEM, OREGON