


N

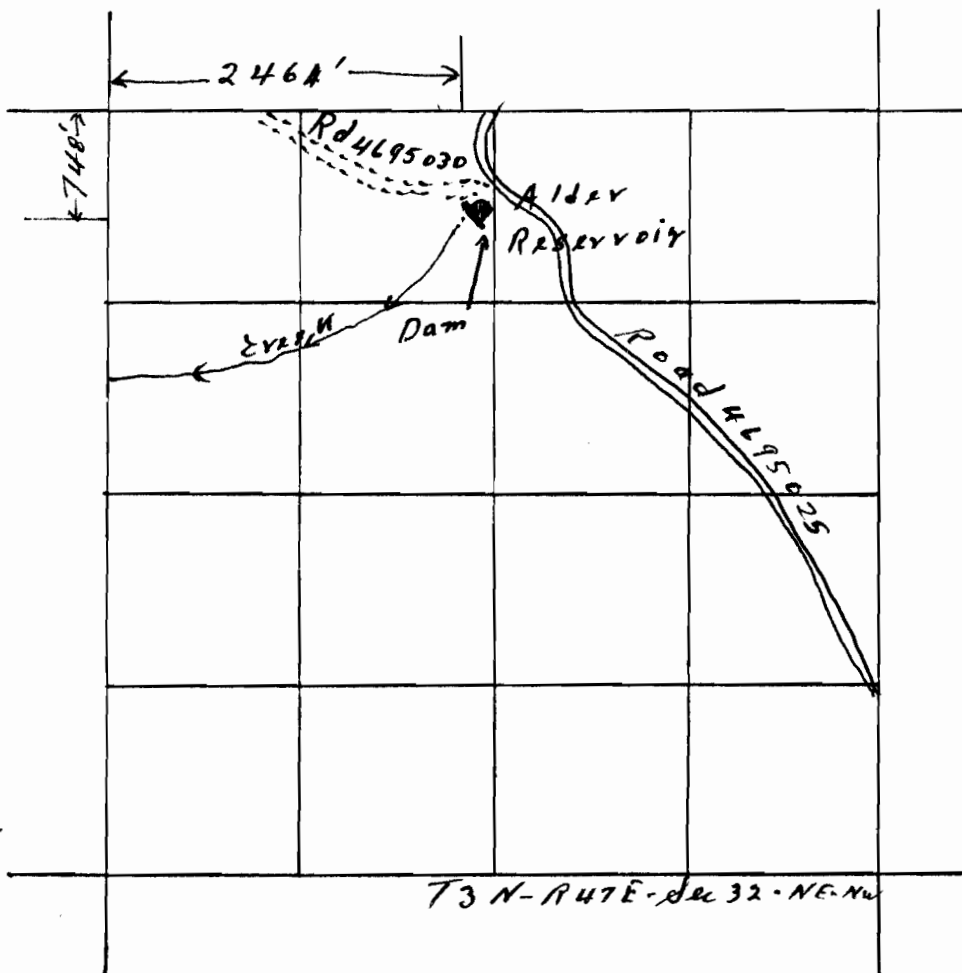

4 inches = 1 mile

Application No. R-65796
Permit No. R10776

RECEIVED

APR 20 1982
LAND RESOURCES DEPT
SALEM, OREGON