


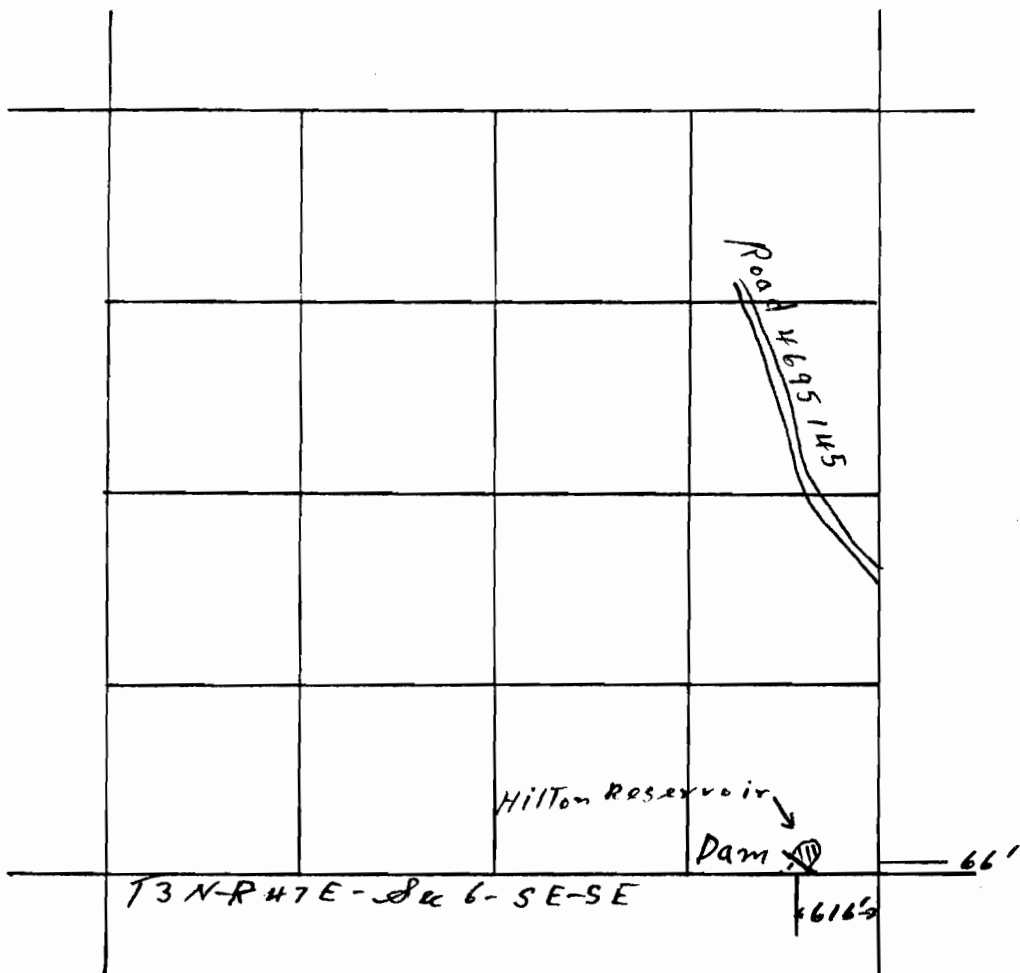

4 inches = 1 mile

Application No. R-65297

Permit No. R10777

PRINTED

2-10-60

LAND OFFICES DEPT
SALEM, OREGON