


N

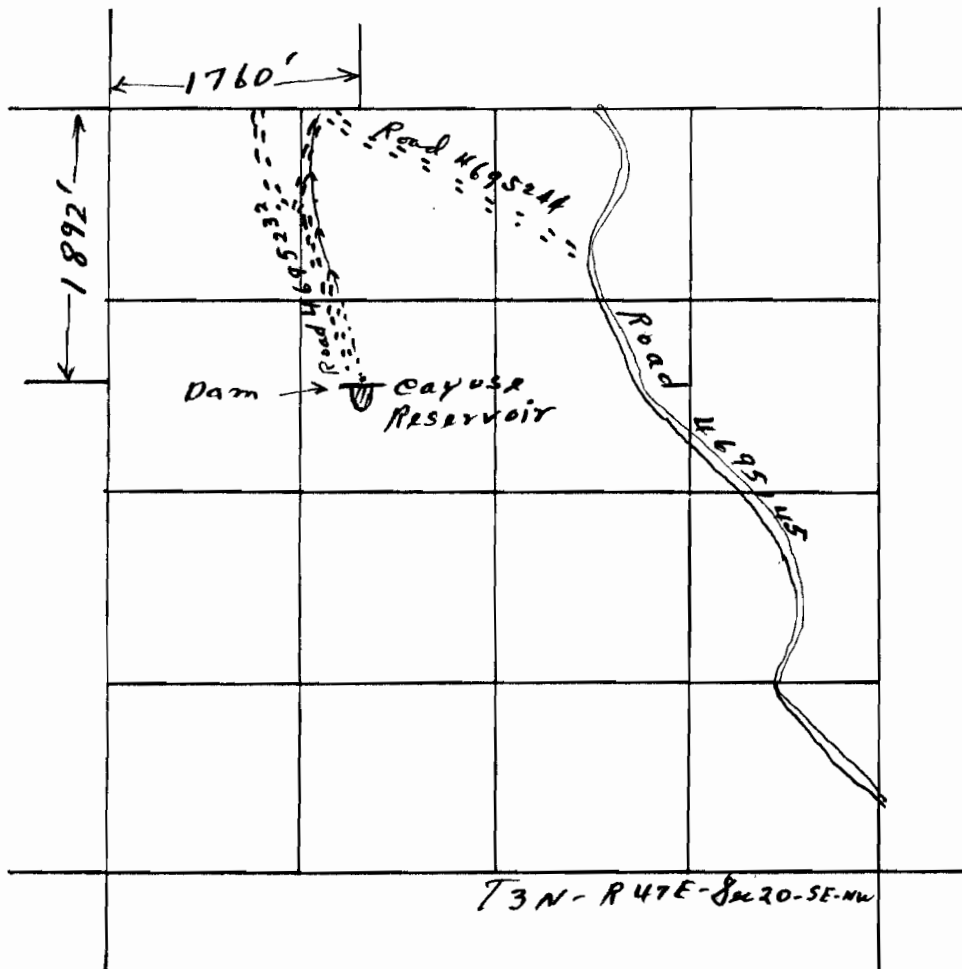

4 inches = 1 mile

Application No. R-65798
Permit No. R10778

RECEIVED
JAN 29 1953
LAND OFFICES DEPT
SALEM, OREGON