


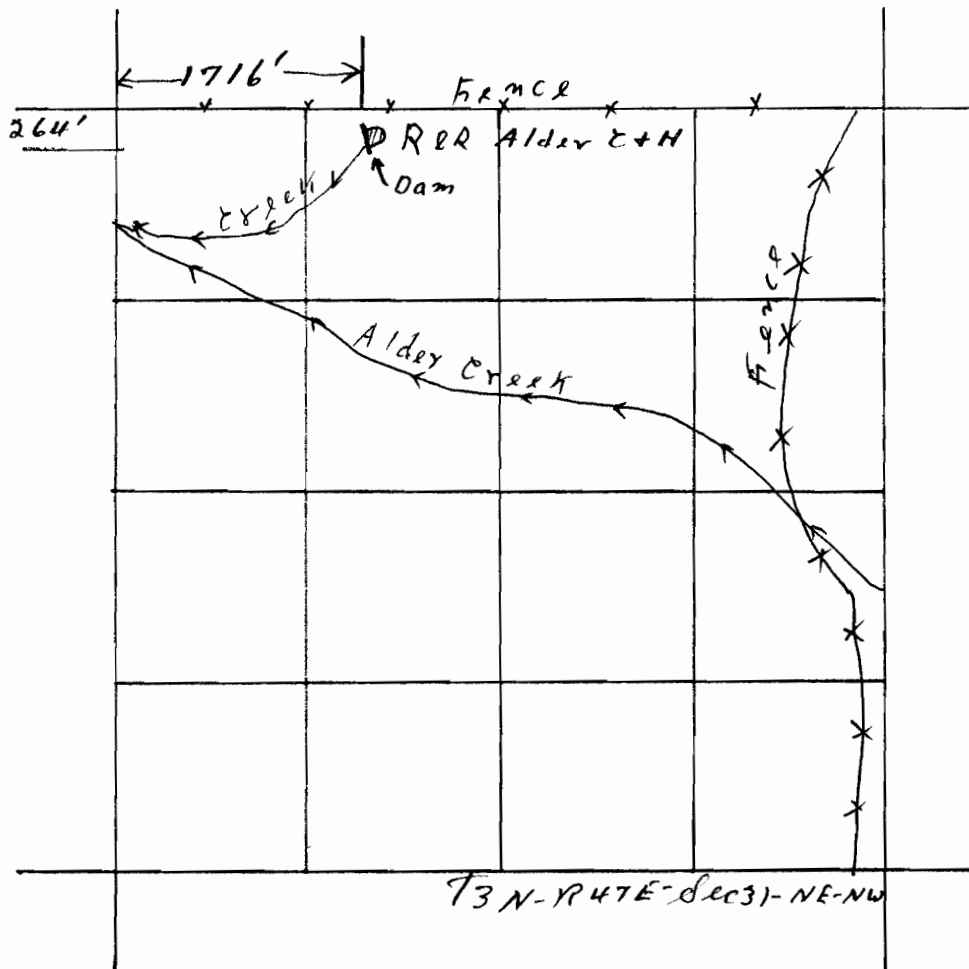

4 inches = 1 mile

Application No. R-65799

Permit No. R10779

RECEIVED

APR 19 1932

LAND OFFICES DEPT.
SALEM, OREGON