


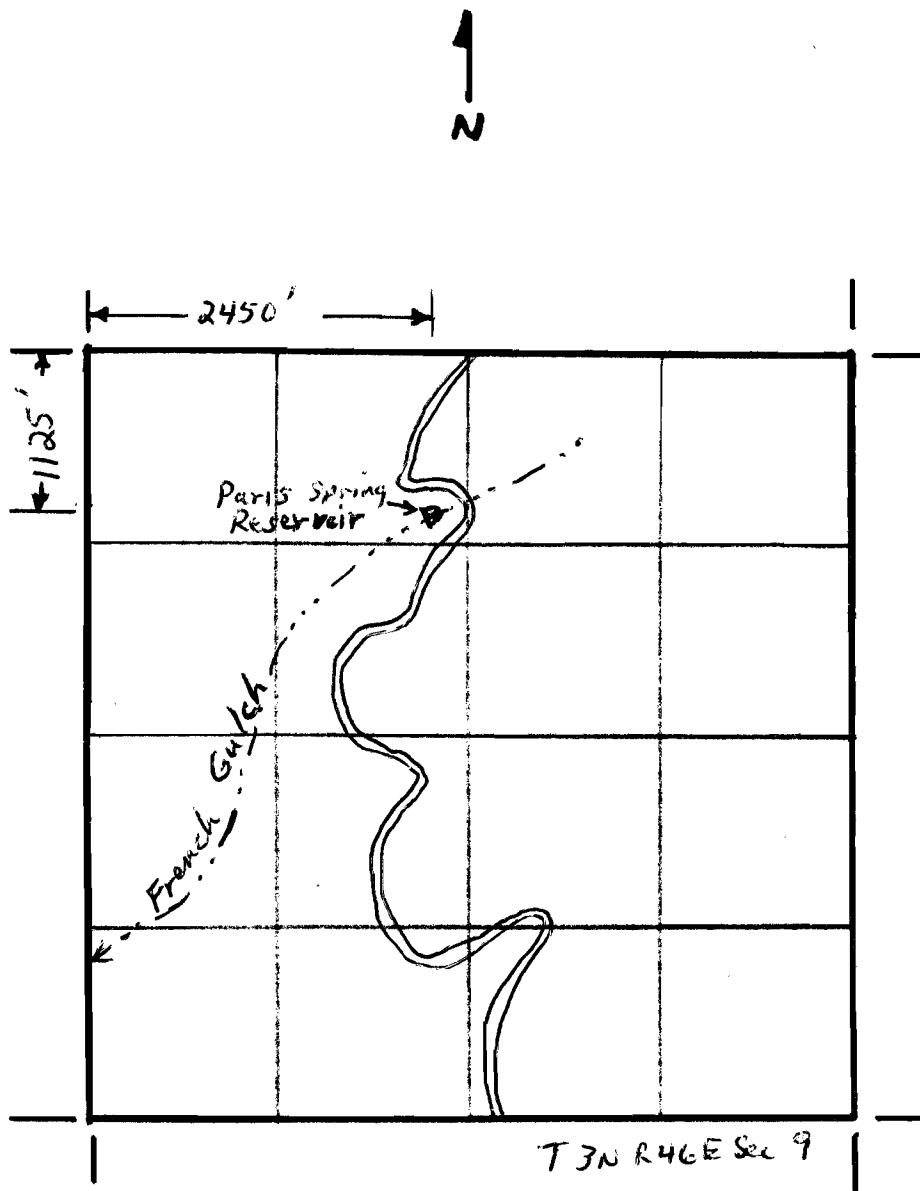

4 Inches = 1 Mile

Application No. R-65800
Permit No. R10780

RECEIVED

APR 29 1962
LANDS DEPT
SALEM, OREGON