
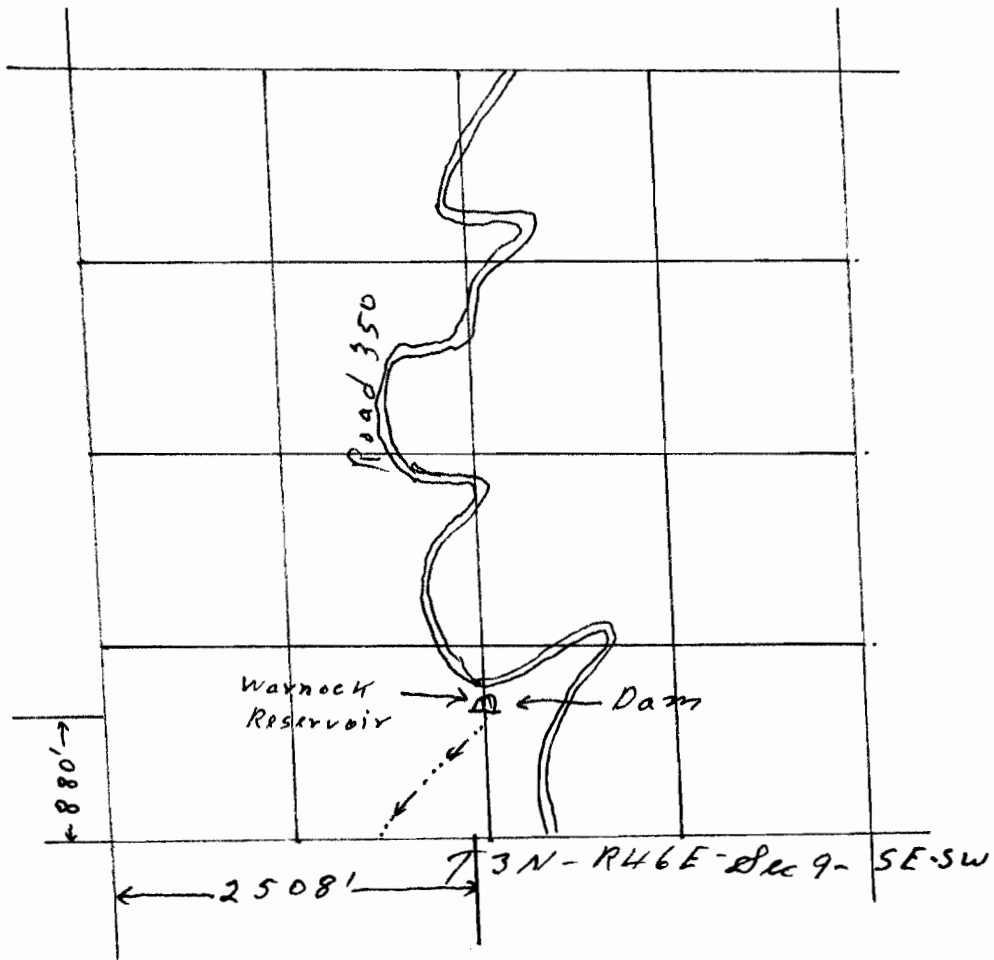


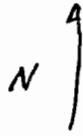

Application No. R-65801
Permit No. R10781

4 inches = 1 mile

RECEIVED
APR 29 1962
LAND DIVISION DEPT.
SALEM, OREGON