


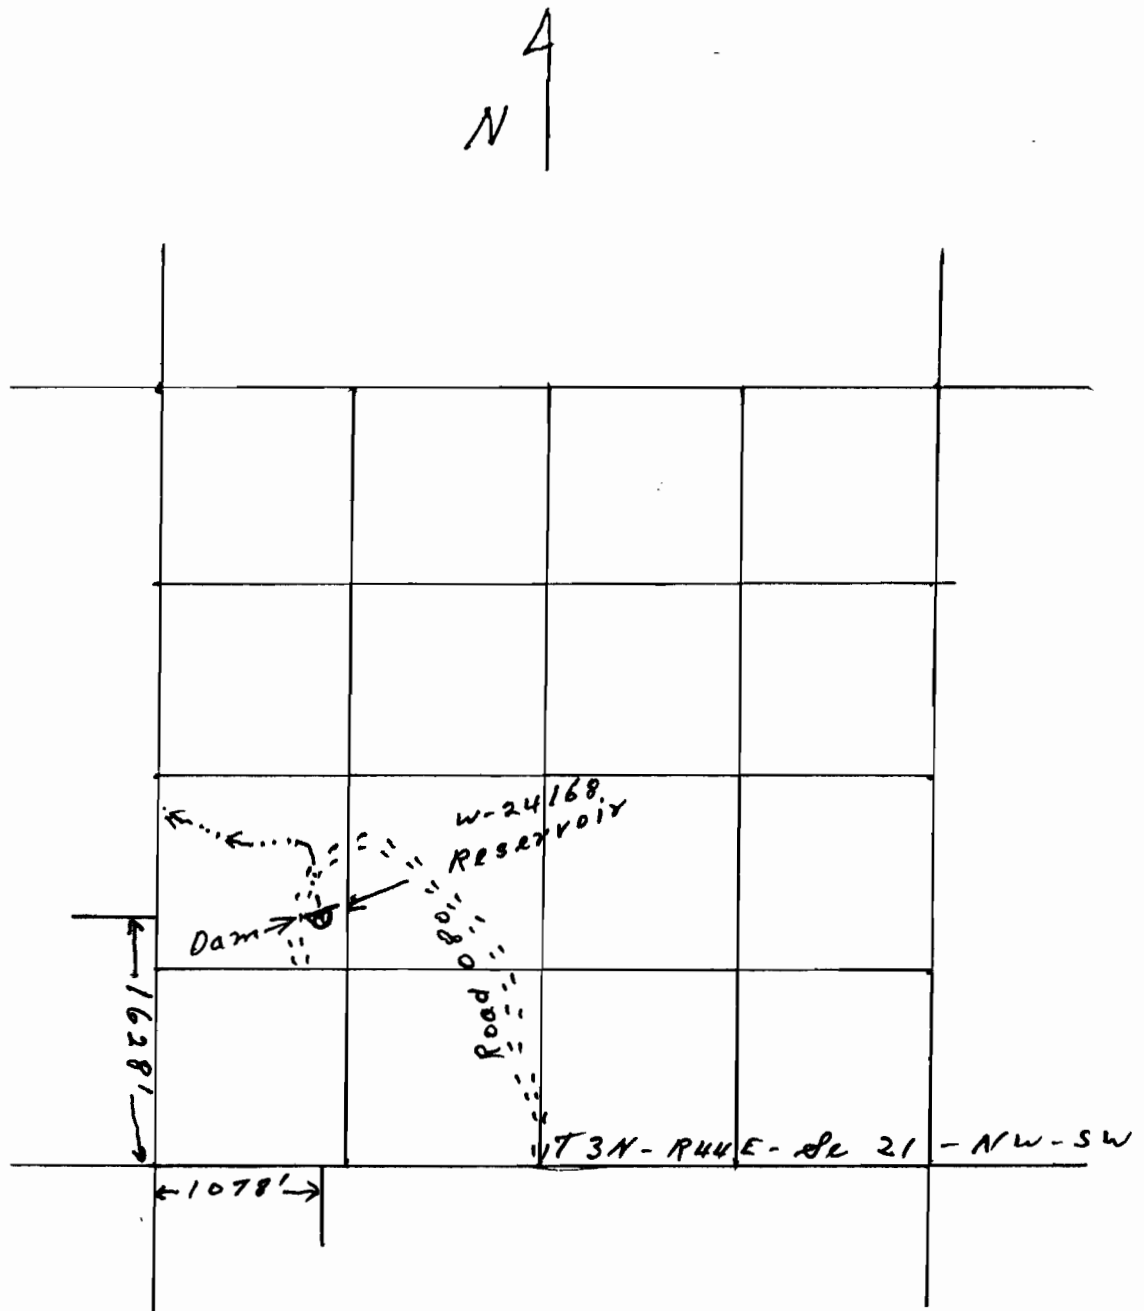

4 inches = 1 mile

Application No. R-65802

Permit No. R10782

RECEIVED

APR 29 1982

LAND RESOURCES DEPT.
SALEM, OREGON