


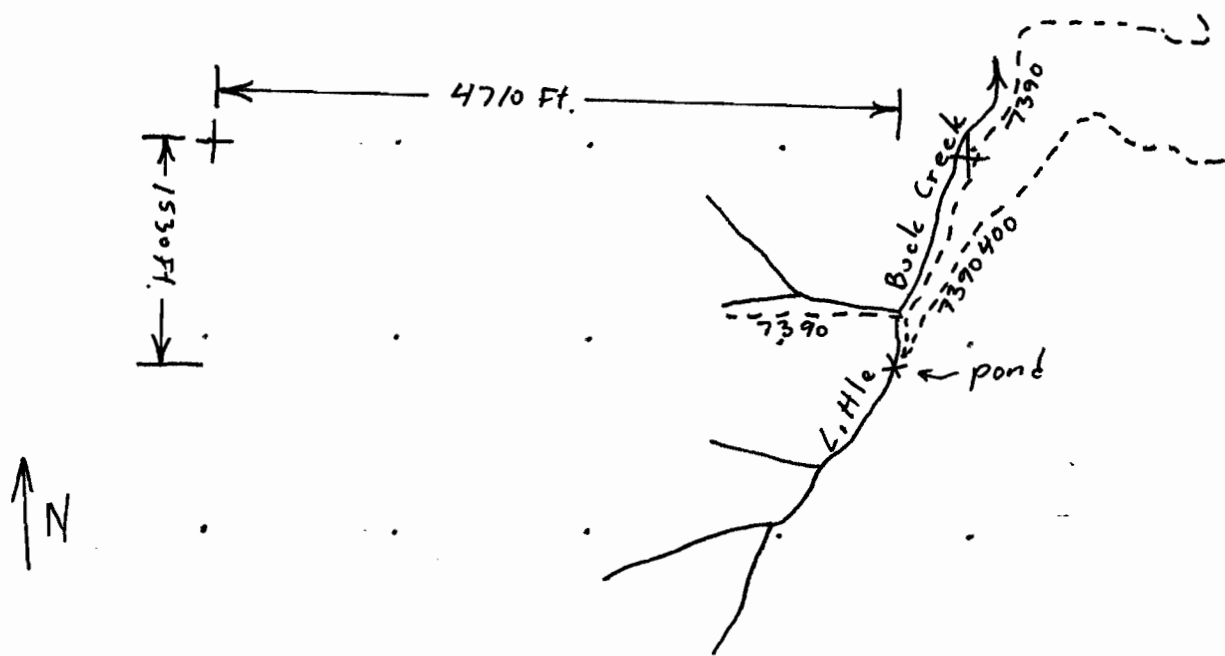

4 inches =
1 mile

+ T 9 S R 35 E Sec 35 +

Application No. R66613
Permit No. R10788

RECEIVED
SEP 22 1983
WATER RESOURCES DEPT.
SALEM, OREGON