


N

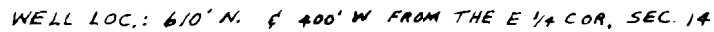

FINAL PROOF SURVEY

UNDER

Cont. # 63563

Surveyed SEPT. 29 1988, by B. BISHOP

RECEIVED

DATE 1-26-90

WATER MASTER DISTRICT #11

BY Two

11-7-88

41013-180-145C LLC

G-7873