


G-7843
63564

T. 29S., R. 16E., W. M.

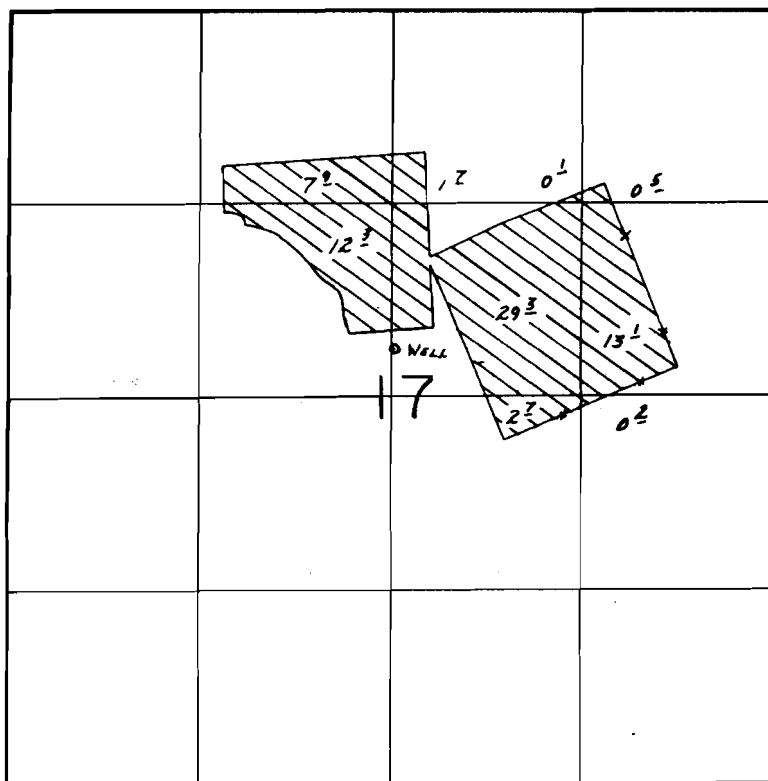

WELL LOC.: 2310'S & 2620' N. FROM NE COR. SEC. 17.

SCALE: 1" = 1320'

FINAL PROOF SURVEY UNDER

Application No. G-8446. Permit No. G-7843.....
IN NAME OF

CHARLES M. & FERNETTE M. MCDOWELL

Surveyed June 28, 1988, by B.W. BISHOP.....

12/19/88
B.W.B.