


# T. I. N., R. I. W., W. M.

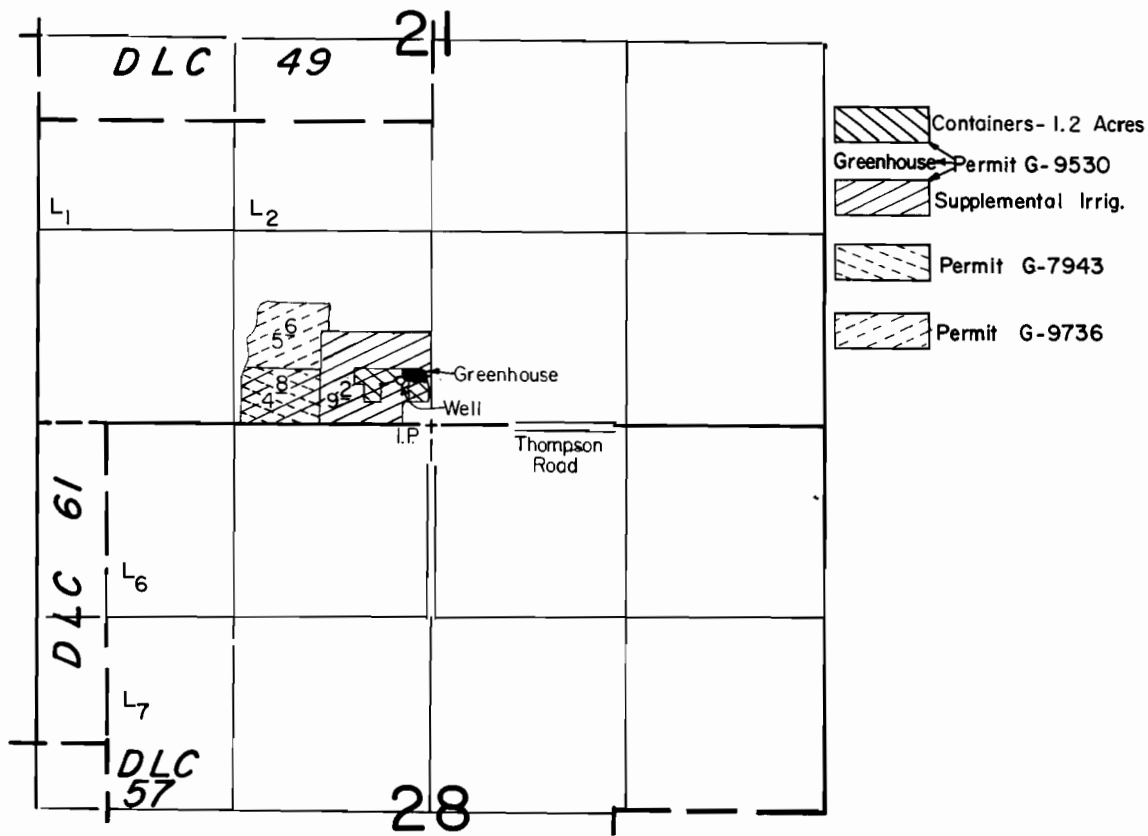

Well Loc. : 300' N. & 200' W. from S. 1/4 Cor. Sec. 28.

Scale : 1" = 1320'

## FINAL PROOF SURVEY UNDER

G- 8610                      G-7943  
 G- 9252                      G-9530  
 Application No. G-10627    Permit No. G-9736.....  
 IN NAME OF

### ALFRED MEISNER ; CASCADIAN NURSERIES

Surveyed AUG. 9 1988, by T. Warren.....