


T. 23S., R. 27E., W.M.

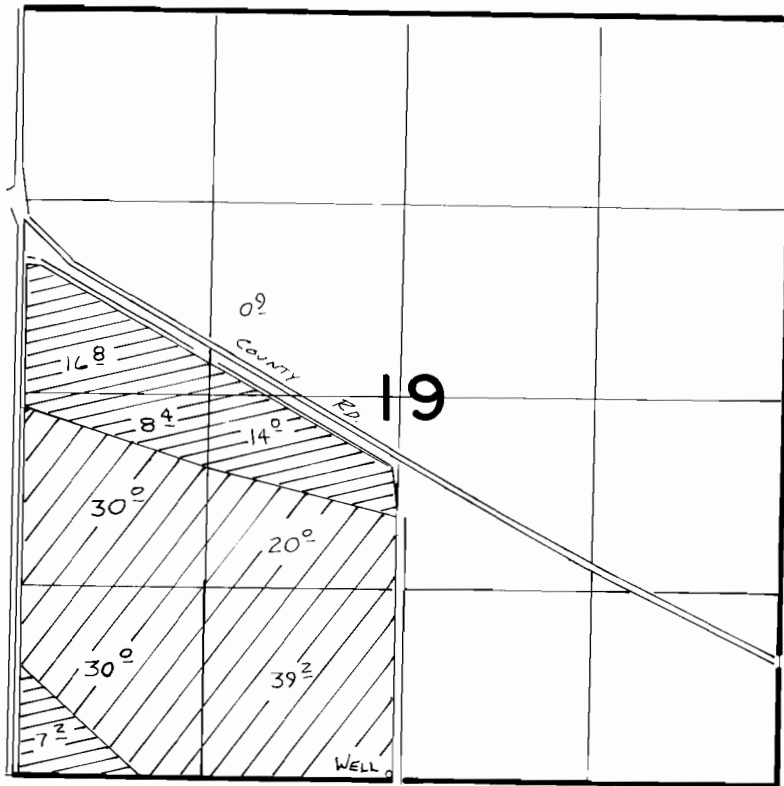

WELL LOC: 40' N. & 30' W. FROM S 1/4 CORNER SEC. 19



Scale 1" = 1320'

FINAL PROOF SURVEY UNDER

-  PRIM.
-  SUPPL

Application No. **G:8643** Permit No. **G:8056**
IN NAME OF

MEADOW...CREEK...ENTERPRISES..

Surveyed **5-6** 19**88**, by **B.W. BISHOP**