


T. 8 S., R. 39 E., W.M.

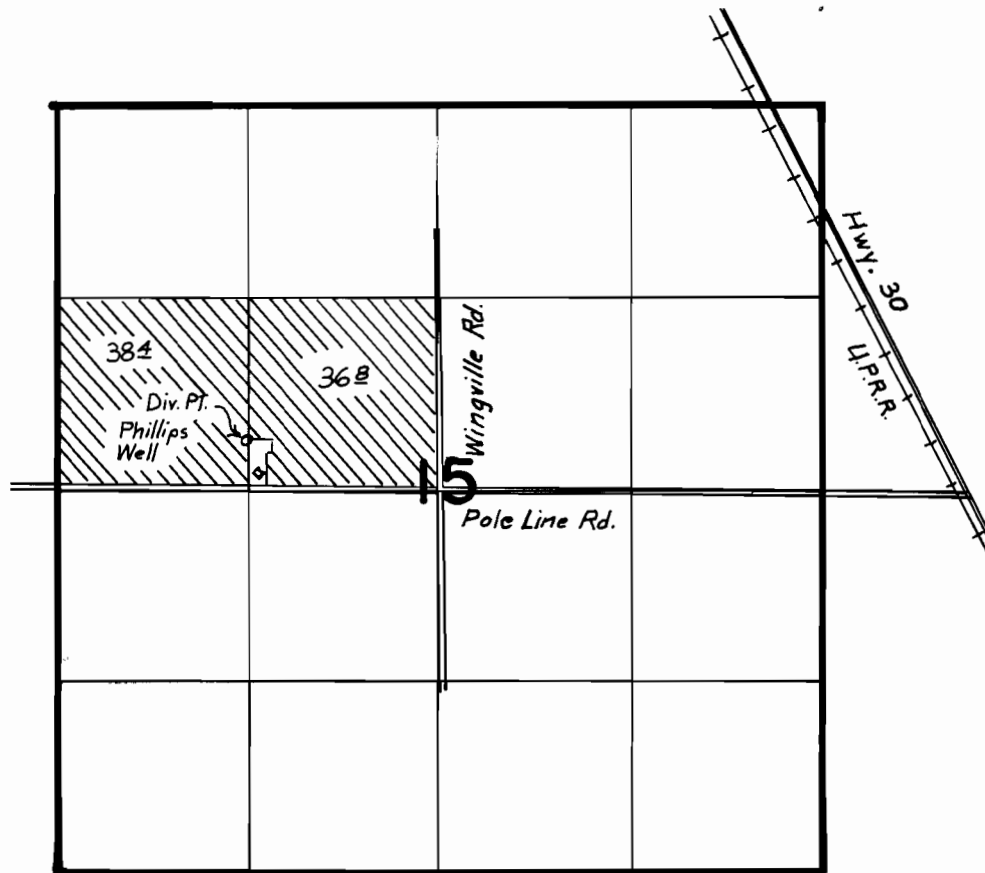

The well is located 300' N. & 1320' E. from the W. 1/4 of sec. 15.

FINAL PROOF SURVEY
UNDER

Application No. G-8669 Permit No. G-8049
IN NAME OF

LEROY W. PHILLIPS

Surveyed 7-27 1988, by Kenn Kemp



Scale 1" = 1320'