


T. 22S., R. 31E., W.M.

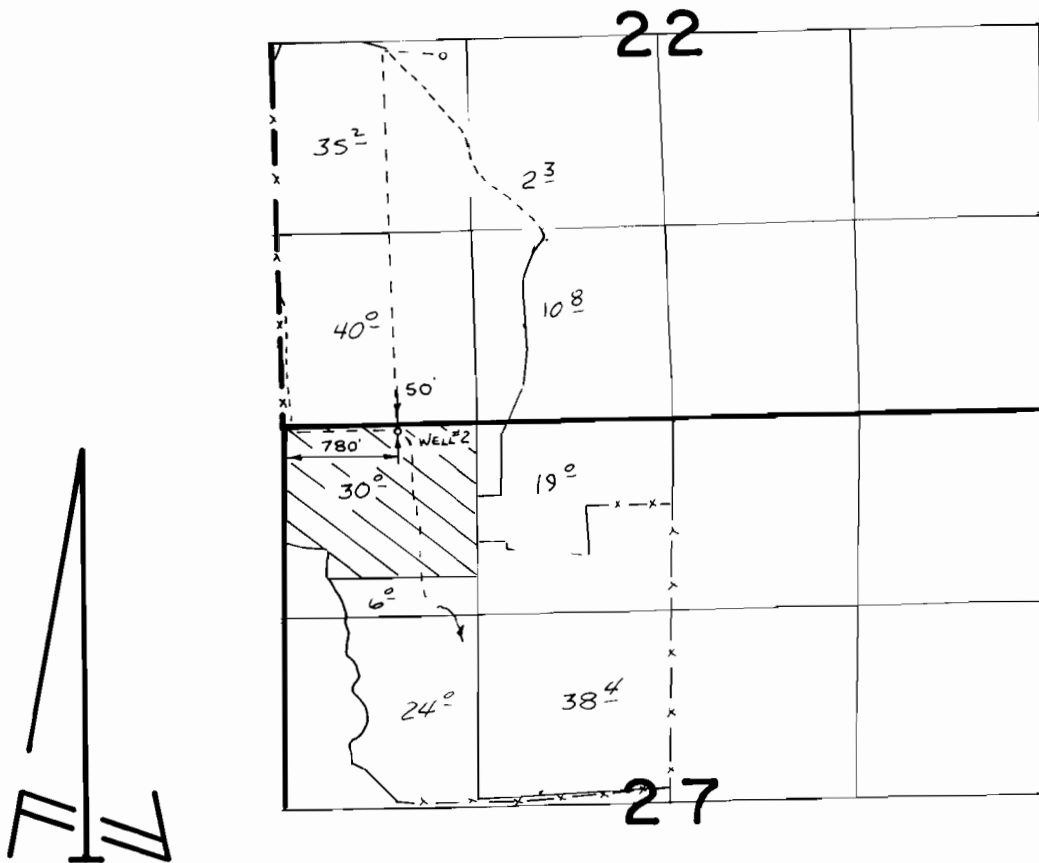

SCALE 1" = 1320'

# FINAL PROOF SURVEY UNDER

Application No. **G-8700** Permit No. **G-8058**..  
IN NAME OF

.....**DELMER CLEMENS**.....

Surveyed ..5-10..... 1988., by *J.M. Seamore*.....