


T. 22S., R. 31E., W.M.

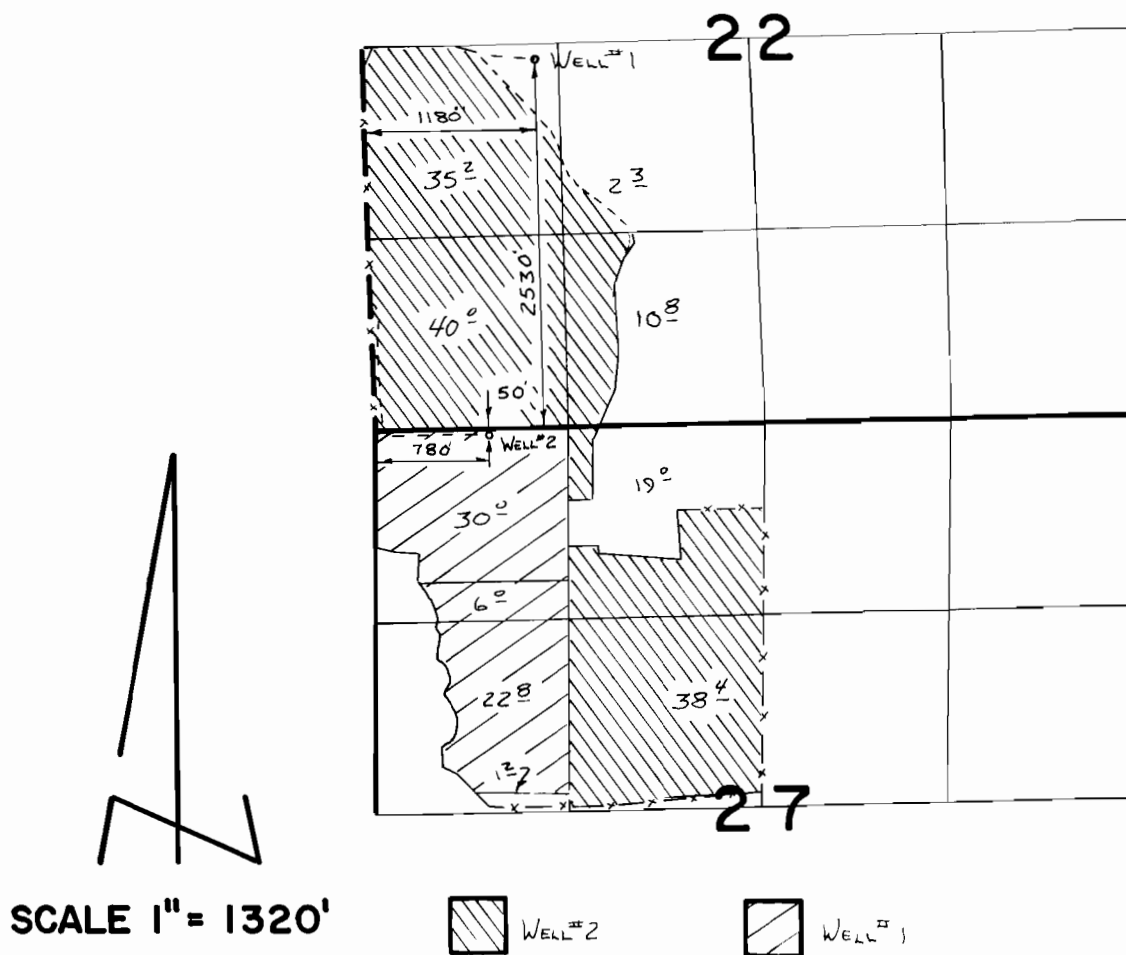

FINAL PROOF SURVEY
UNDER

Application No. **G-9283** Permit No. **G-8771**...
IN NAME OF

DELMER CLEMENS

Surveyed **5-10-1988**, by **J.M. Schmorde**...