


T. 3 S., R. 2 & 3 E.

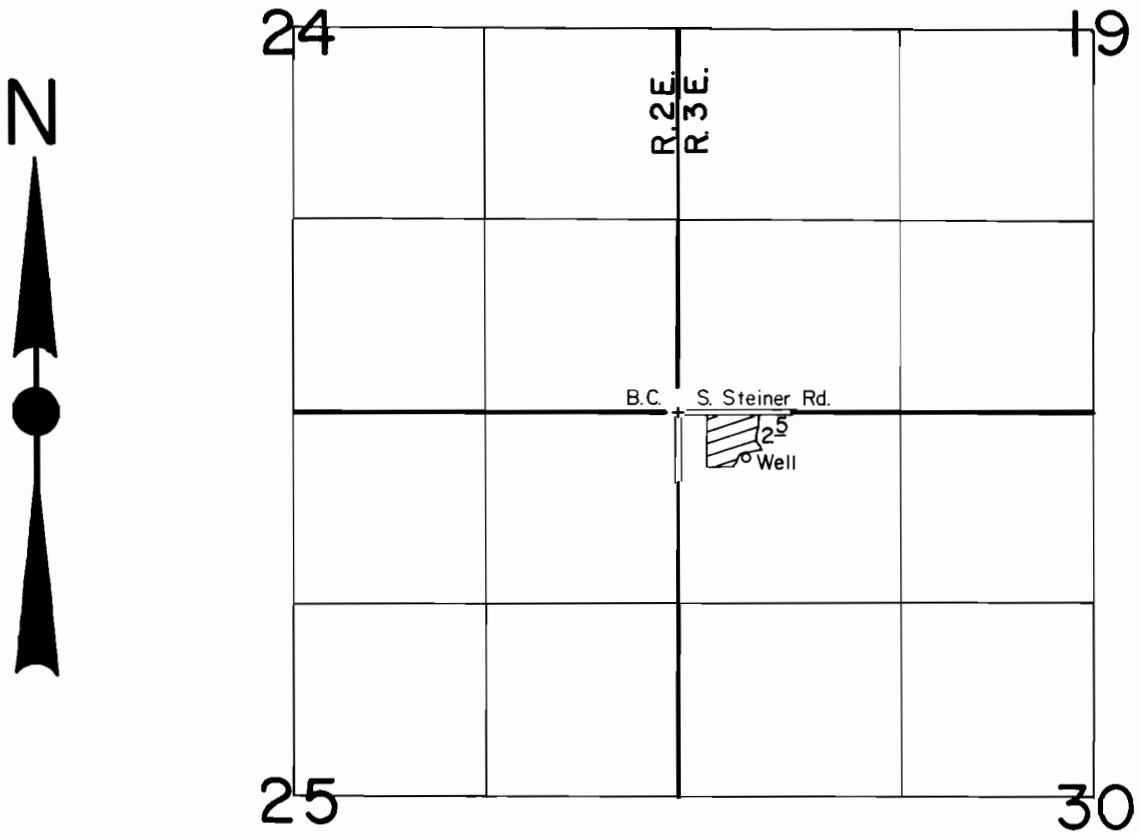

Well Loc.: 320' S. & 460' E. from NW Cor. Sec. 30.

Scale : 1" = 1320'

FINAL PROOF SURVEY
UNDER

Application No. G-8734 Permit No. G-8081.....
IN NAME OF

PAUL R. & NOBUKO HEITMEYER

Surveyed AUG. 3 1988, by T. Warren