
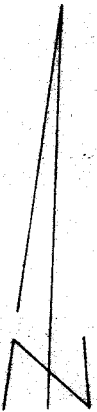


G-8304
63578

T. 1N., R. 33E., W.M.

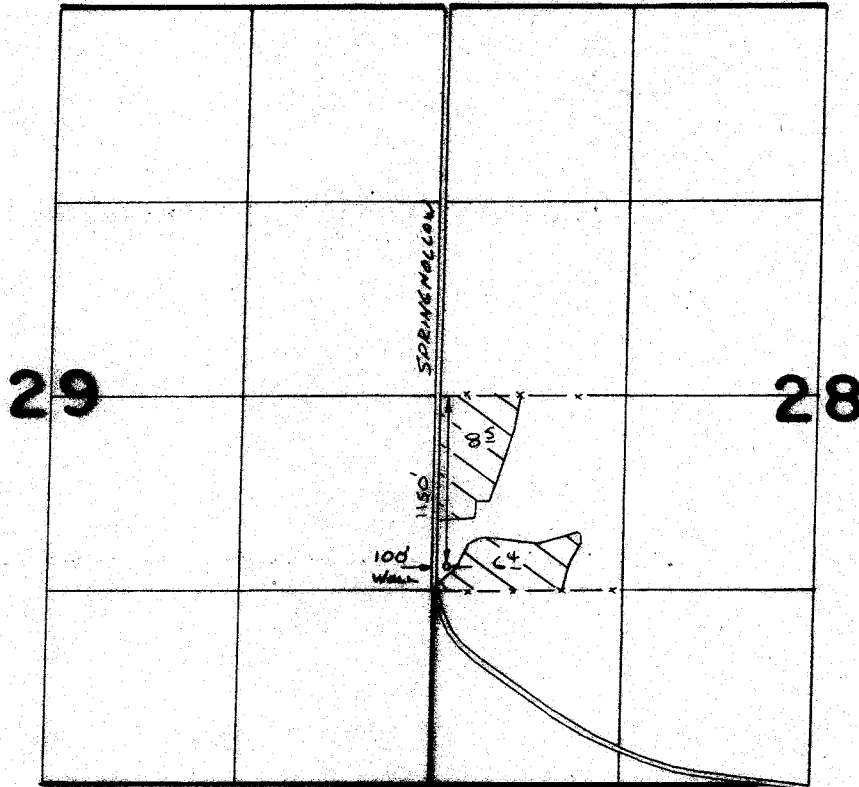

SCALE 1" = 1320'

FINAL PROOF SURVEY
UNDER

Application No. **G-8913** Permit No. **G-8304**
IN NAME OF

ANDERSON LAND & LIVESTOCK

Surveyed 12-23 1987, by V.L. Church