
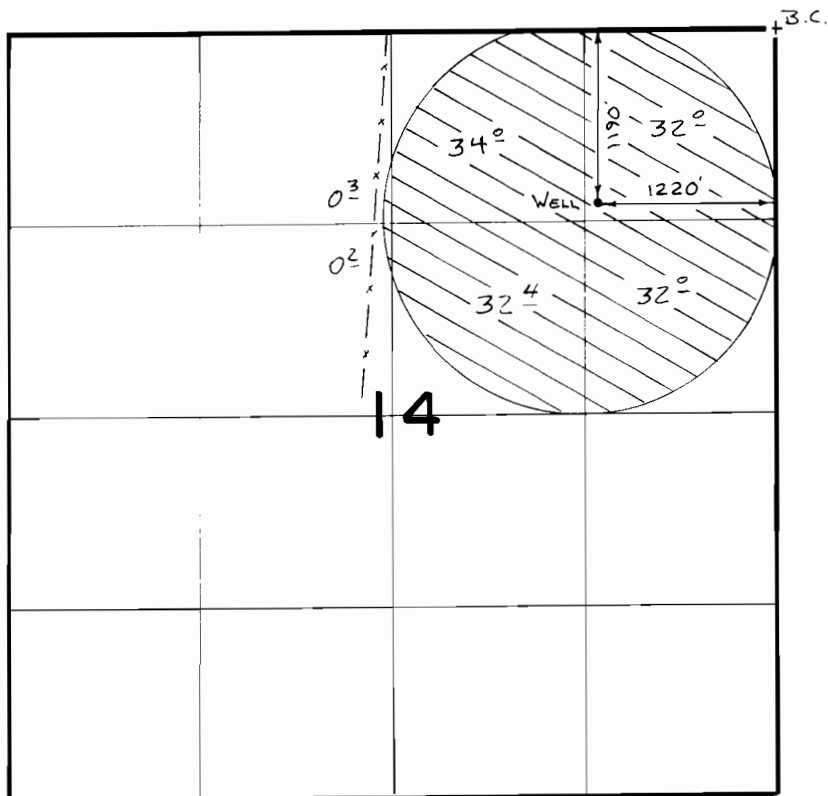


T. 23S., R. 32E., W.M.

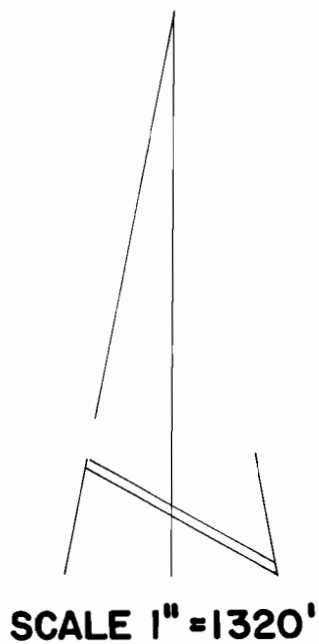

FINAL PROOF SURVEY
UNDER

Application No. **G-8916** Permit No. **G-8311**.....
IN NAME OF

ORAMARTIC, INC......

Surveyed 5-7..... 1988, by J.M. Schmorde.....