


T. 25S., R. 34E., W.M.

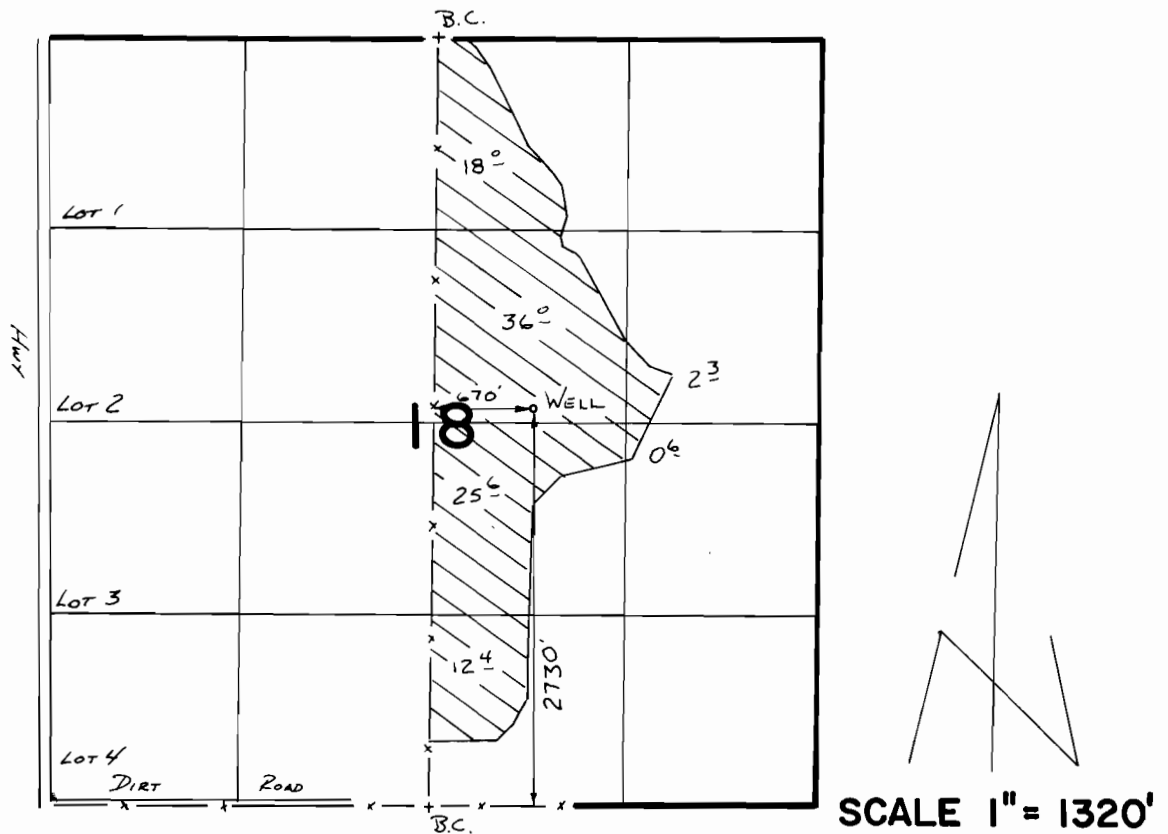

FINAL PROOF SURVEY UNDER

Application No. **G:8993** Permit No. **G:8373**
IN NAME OF

CLARENCE E. & FLORENCE H. MORLAN, SR. - CLARENCE E. MORLAN, JR.

Surveyed 5-7-1988 by V.L. Church