


T.10&11S., R.14E., W.M.

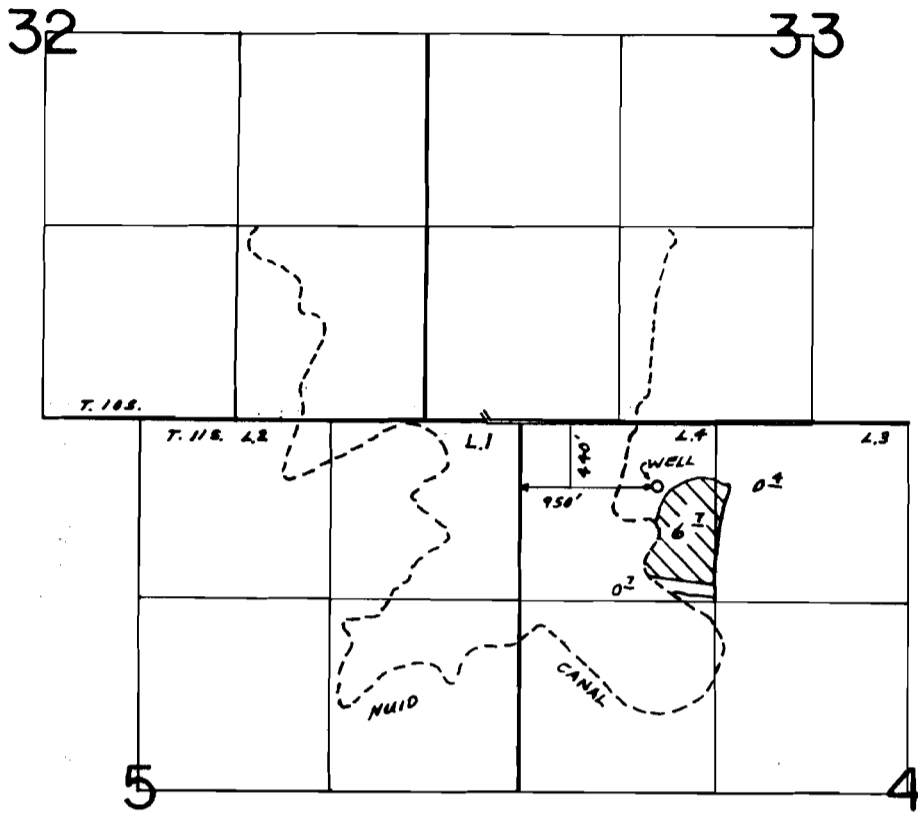

SCALE: 1"=1320'

FINAL PROOF SURVEY
UNDER

Application No. G-9045 Permit No. G-8660....
IN NAME OF

JERRY R. PATTERSON

Surveyed JULY...11... 19.8.8, by B.BISHOP.....

Cert. #63581

RECEIVED

DATE 1-26-90
WATER MASTER DISTRICT #11
BY JMY

12-9-88
41031-179-90R LLC

G-8660