


T. 9 S., R. 40 E., W.M.

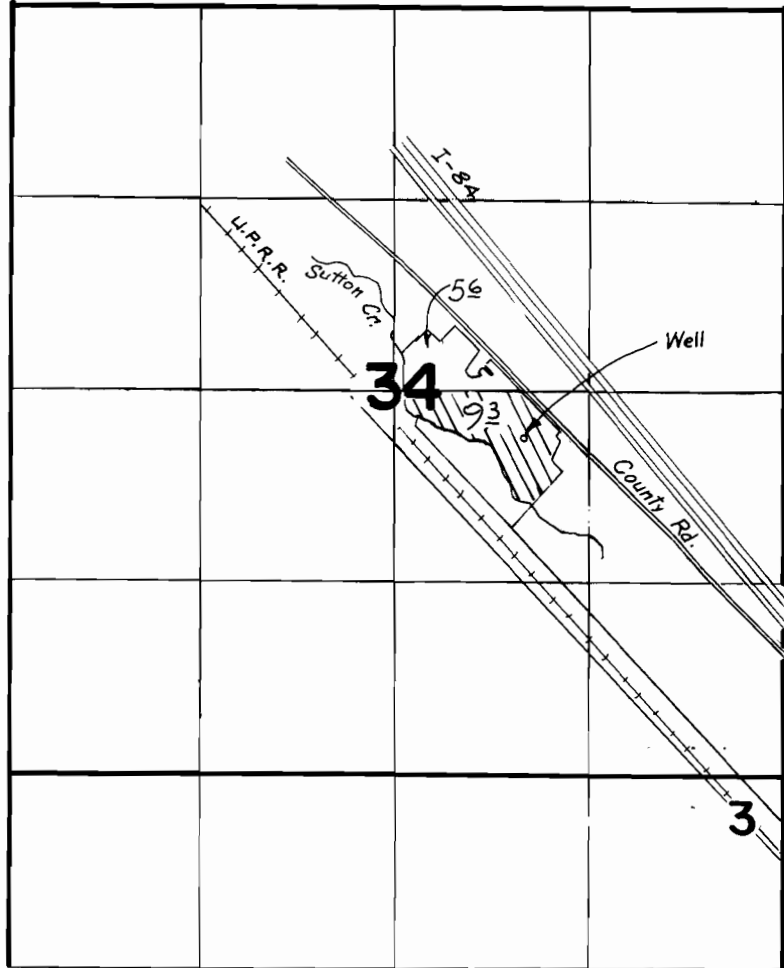

SCALE 1" = 1320'

T. 9 S.
T. 10 S.

Well Loc.: 2330' N. & 1780' W. from SE Cor. Sec. 34,

FINAL PROOF SURVEY UNDER

Application No. *G-9153* Permit No. *G-8525*
IN NAME OF

.....KEN. L. THUERBACH.....

Surveyed *5-20* 19*88*, by *V.L.G.*