


G-857Z
63583

T. 25S., R. 15E., W.M.

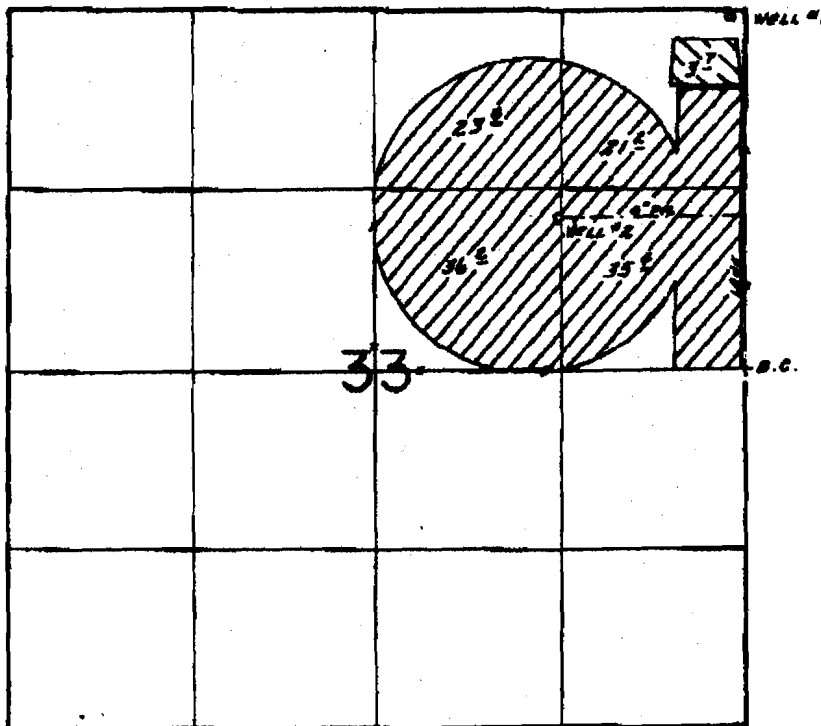

WELLS Loc.: #1-2530' N. & 112' W.; #2-1120' N. & 1350' W.;
BOTH FROM E. 1/4 COR. SEC. 33.

-  Well 1
-  Well 2

SCALE: 1" = 1320'

FINAL PROOF SURVEY UNDER

Application No. G:9192.. Permit No. G:8572....
IN NAME OF

ALFRED L. & ALTA B. ROBERTS

Surveyed Oct. 20... 1983, by J.M. TOLH.....
June 9 1988 B.W. BISHOP