
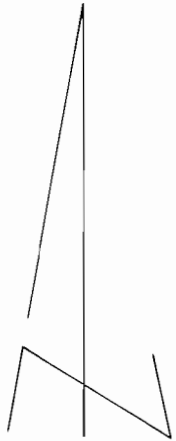


T. 27S., R. 33E., W.M.

COUNTY ROAD

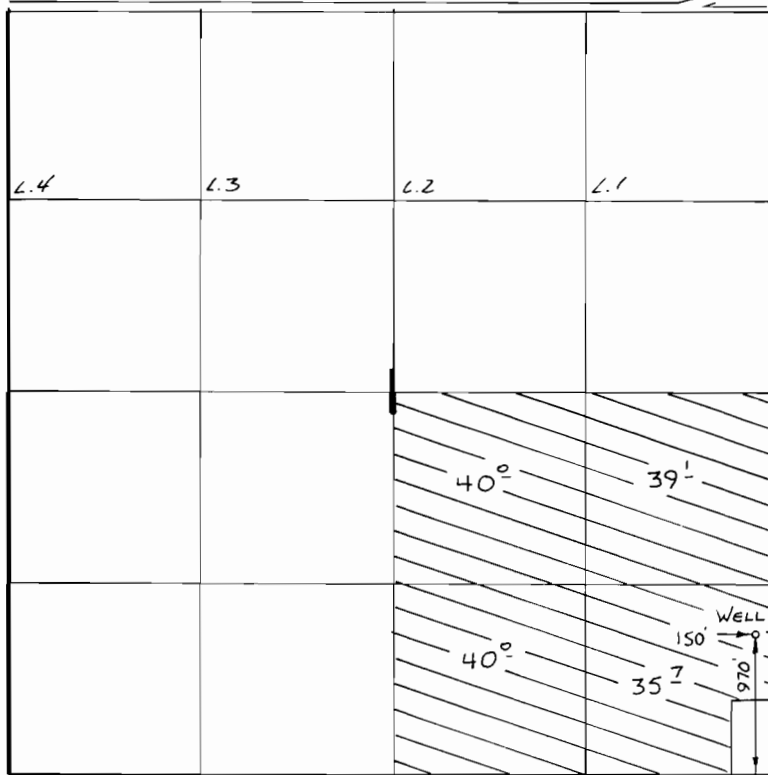

SCALE 1" = 1320'

FINAL PROOF SURVEY
UNDER

Application No. **G:9219** Permit No. **G:9840**
IN NAME OF

.....**RALPH**.....**KILLINGER**.....

Surveyed 5-10..... 1988, by T.M. WARREN.....