


T. 35 S., R. 5 W., W.M.

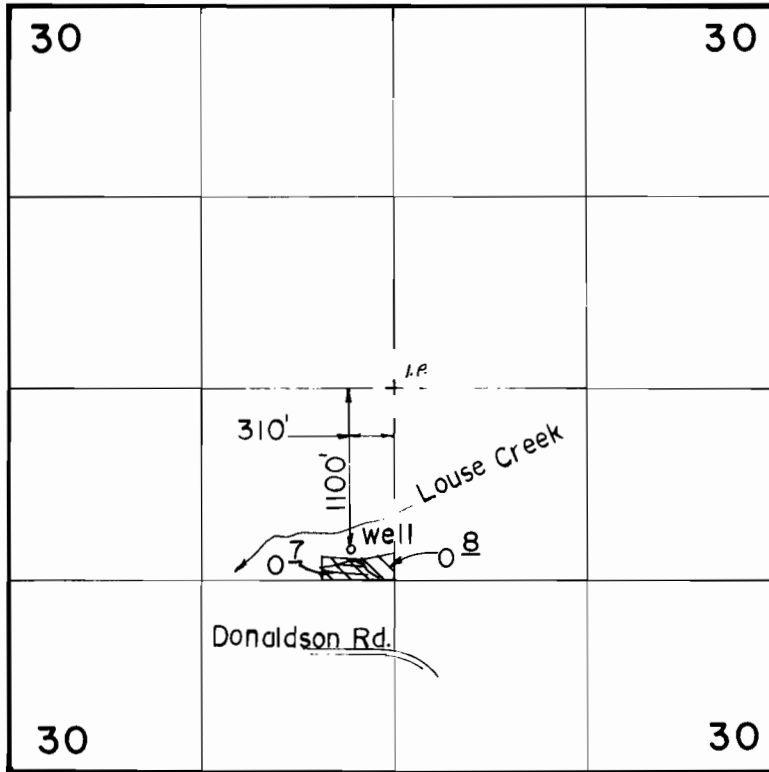

Scale: 1" = 1320'

**FINAL PROOF SURVEY**  
UNDER

Application No. G-9294 Permit No. G-8657  
IN NAME OF

BRUCE & CARROLL ALBERT

Surveyed JULY 29, 1987, by B. S. JAMES