


T2S, R4E, WM

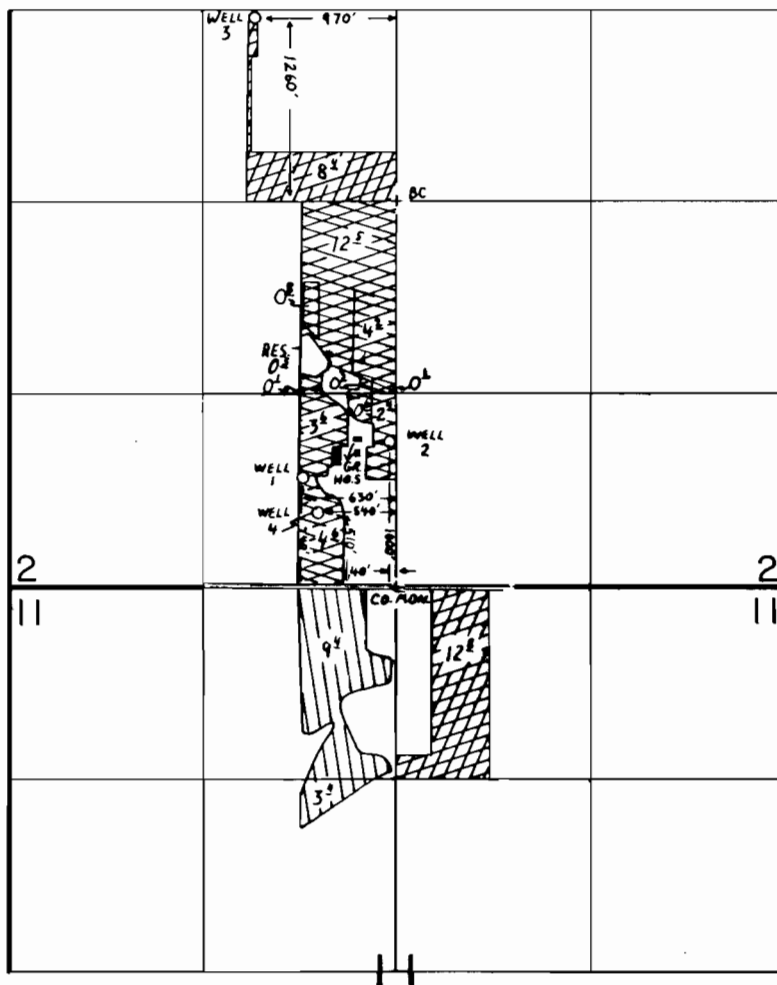

1" = 1320'



G-8746
PRI



G-10481
NURSERY OPERATIONS



G-8746
SUPP



G-10481
NURSERY OPERATIONS

FINAL PROOF SURVEY UNDER

G-9299 G-8746
Application No. G-11318... Permit No. G-10481...
IN NAME OF

HARRY G. & FLORENCE CHATELAIN

Surveyed JULY 28 1987, by J.M. WARREN...

RWK
JFK 144 245
41005 278 422
PTS 1987 A