


T. 34 S., R. 3 W., W. M.

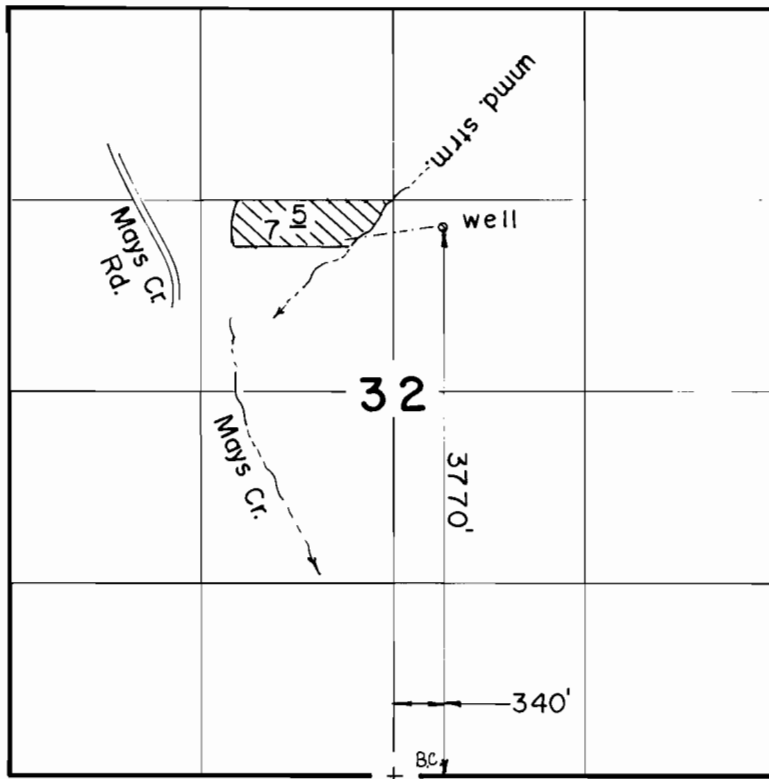

Scale: 1" = 1320'

**FINAL PROOF SURVEY**  
UNDER

Application No. G-9313 Permit No. G-8736  
IN NAME OF

..... DAVID L. GILLIVER .....

Surveyed JUN. 4. 1987, by B.S. JAMES...