


T. 3 & 4 S., R. 1 E., W. M.

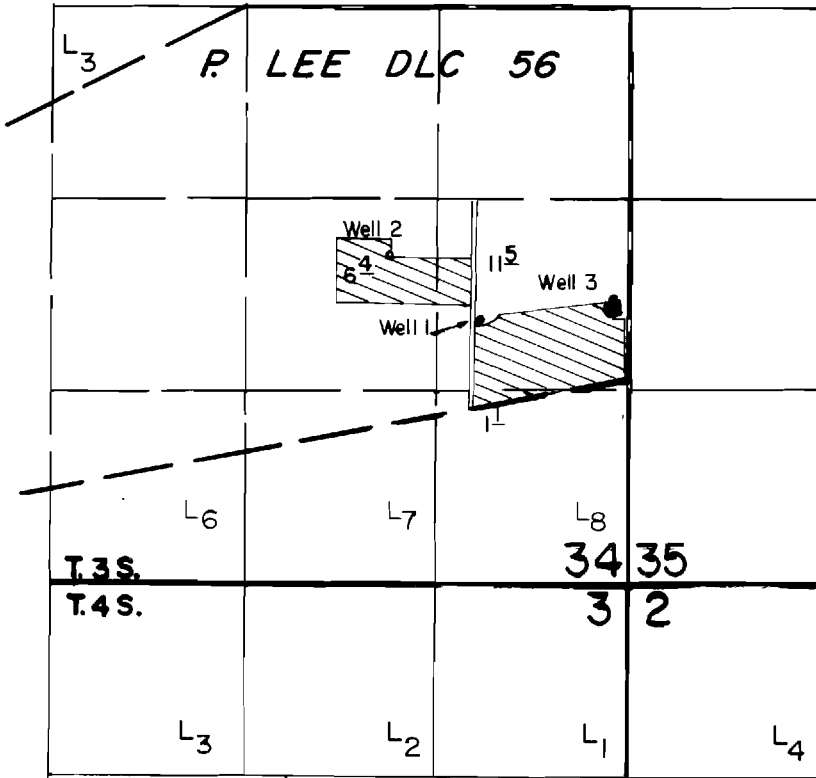

Well 1 Loc. : 400' N. & 1040' W.
 Well 2 Loc. : 840' N. & 1650' W.
 Well 3 Loc. : 540' N. & 100' W., all from SE Cor. LEE DLC 56.

Scale : 1" = 1320'

■ = Seedling Washing

FINAL PROOF SURVEY UNDER

Application No. G-9771.. Permit No. G-8897.....
 IN NAME OF

JACQUE E. PARSONS

Surveyed JULY 23, 1986., by T. Warren.....

41005-278-150 A

TMW 2/6/87