
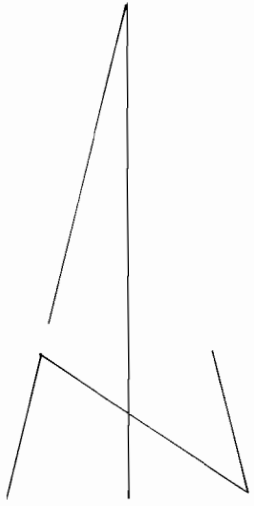


T. 23S., R. 31E., W.M.

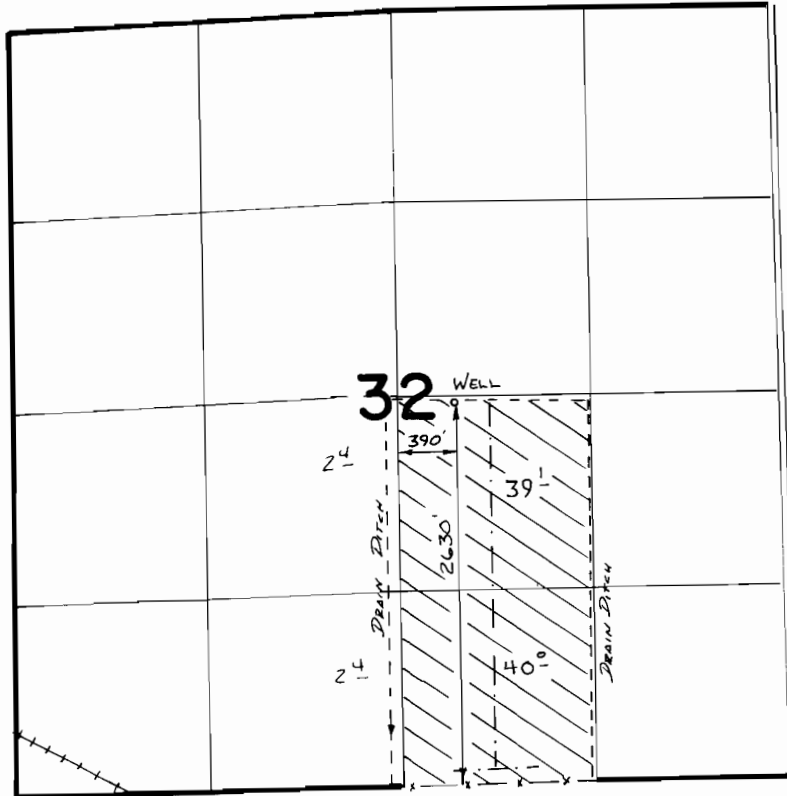

SCALE 1" = 1320'

FINAL PROOF SURVEY
UNDER

Application No. **G:9510**. Permit No. **G:8910**.....
IN NAME OF

ROBERT R. & PATRICIA L. McDONALD

Surveyed ..s:6..... 19.88., by **B.S. James**.....