


T2S, R5E, WM

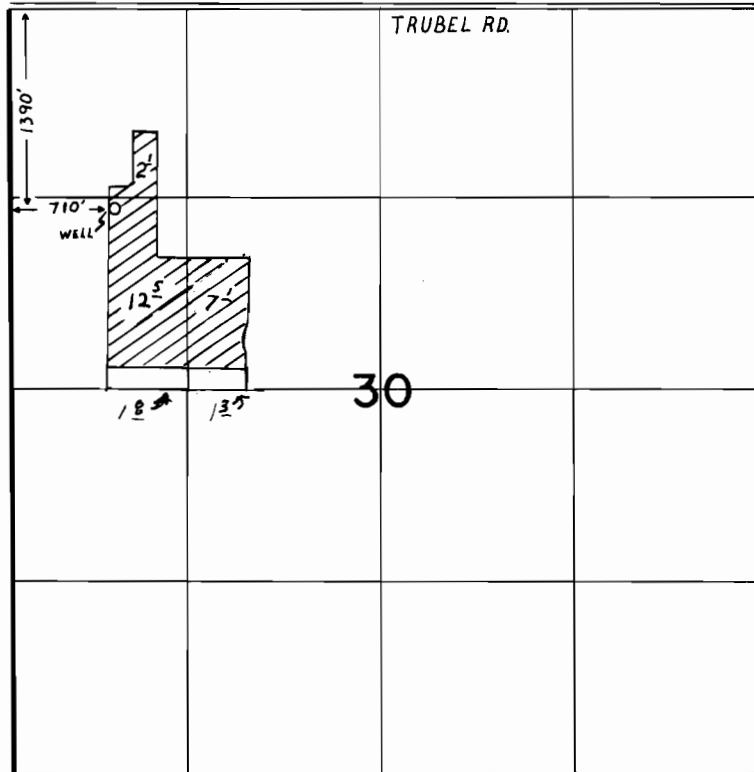

1" = 1320'

FINAL PROOF SURVEY UNDER

Application No. G-9549. Permit No. G-9147.....
IN NAME OF

.....FRED E. WICKERSHAM.....

Surveyed JULY 31, 1987, by T.M. WARREN....