


T3N, RIOW, WM

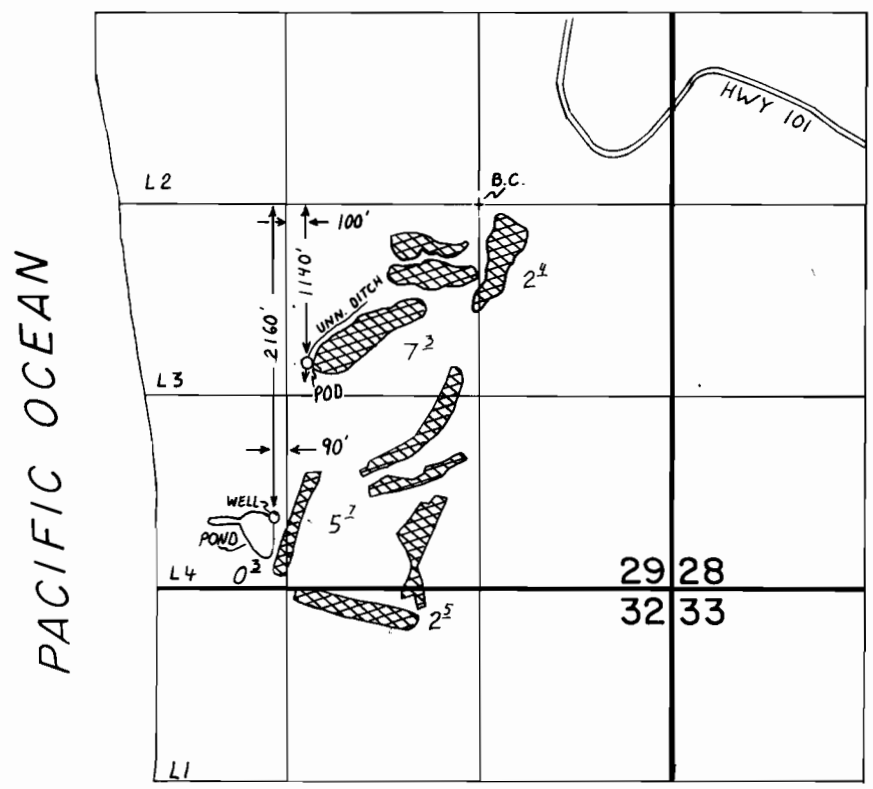

FINAL PROOF SURVEY UNDER

Application No. G-9560 59811... Permit No. G-8853 44877... 

IN NAME OF

MANZANITA GOLF COURSE, INC

Surveyed JULY 8, 1987, by T.M. WARREN.