


# T3N, RIOW, WM

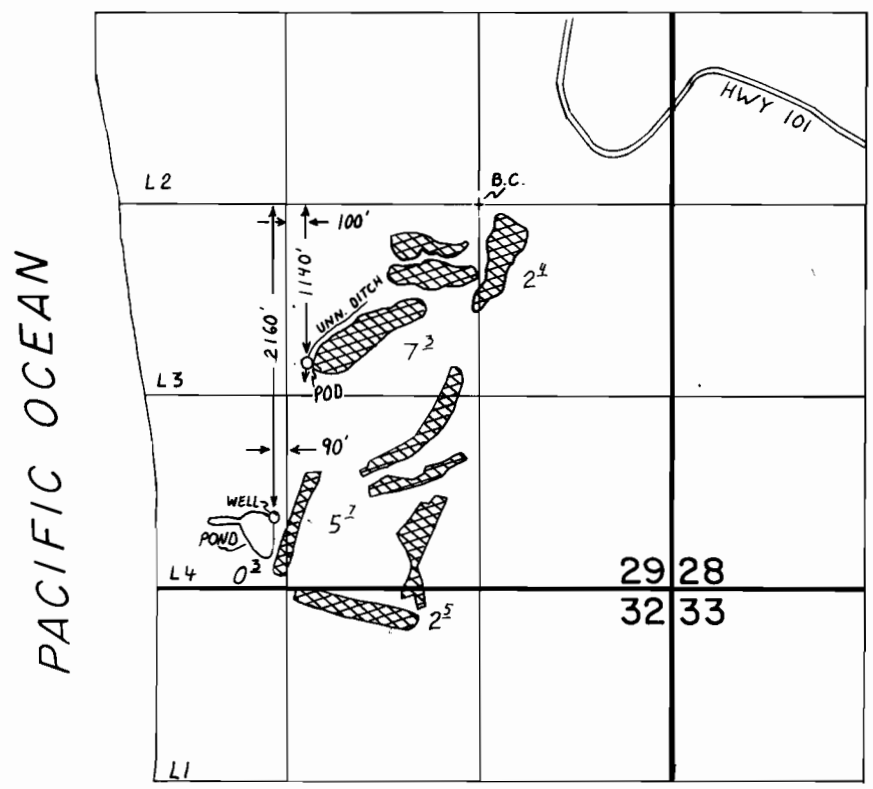

## FINAL PROOF SURVEY UNDER

Application No. G-9560 59811... Permit No. G-8853 44877... 

IN NAME OF

**MANZANITA GOLF COURSE, INC**

Surveyed JULY 8, 1987, by T.M. WARREN.