


T.14S. R. 5W. W.M.

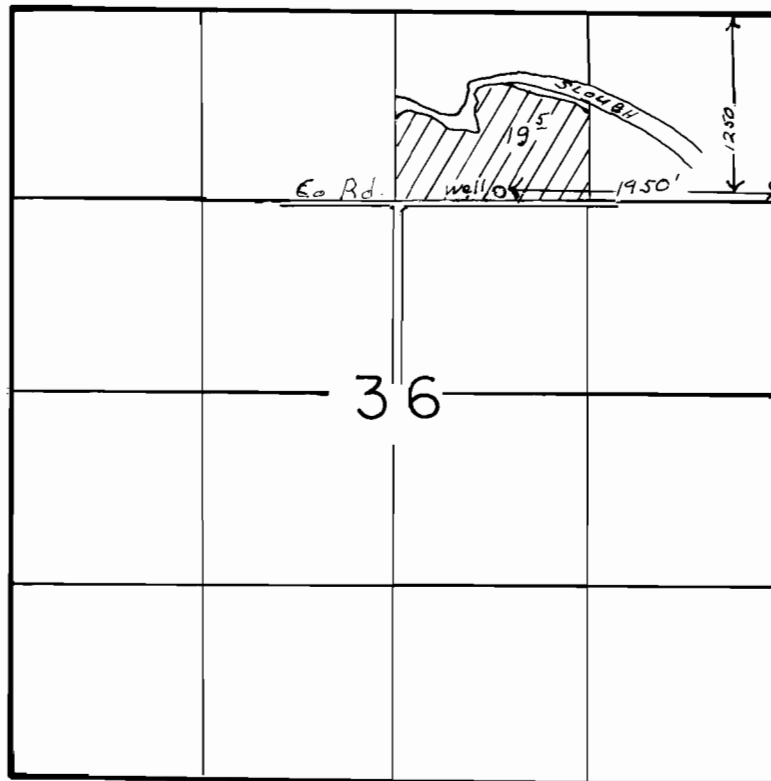

SCALE: 1" = 1320'

FINAL PROOF SURVEY UNDER

Application No. G-9598... Permit No. G-9301.....
IN NAME OF

.....CLIFFORD.....GEORGE.....

Surveyed DEC. 1..... 1987., by T.M. WARREN.....